


NOTE:
ALL DIMENSIONS SHOWN IN THE DRAWING ARE IN MILLIMETER (MM), AND ALL LEVELS OR ELEVATIONS ARE IN METER (M) UNLESS OTHERWISE SPECIFIED.

LEGENDS:

- PROFIED STEEL SHEET (RAL 9006)
- PAINT SPRAYING (RAL 9006)
- EXTERIOR WALL OF OFFICE CONTAINER (RAL 9006)
- SIGNALING PAINT (RAL 9004 AND RAL 1003)
- CONCRETE
- STAINLESS STEEL BIRD PROTECTION

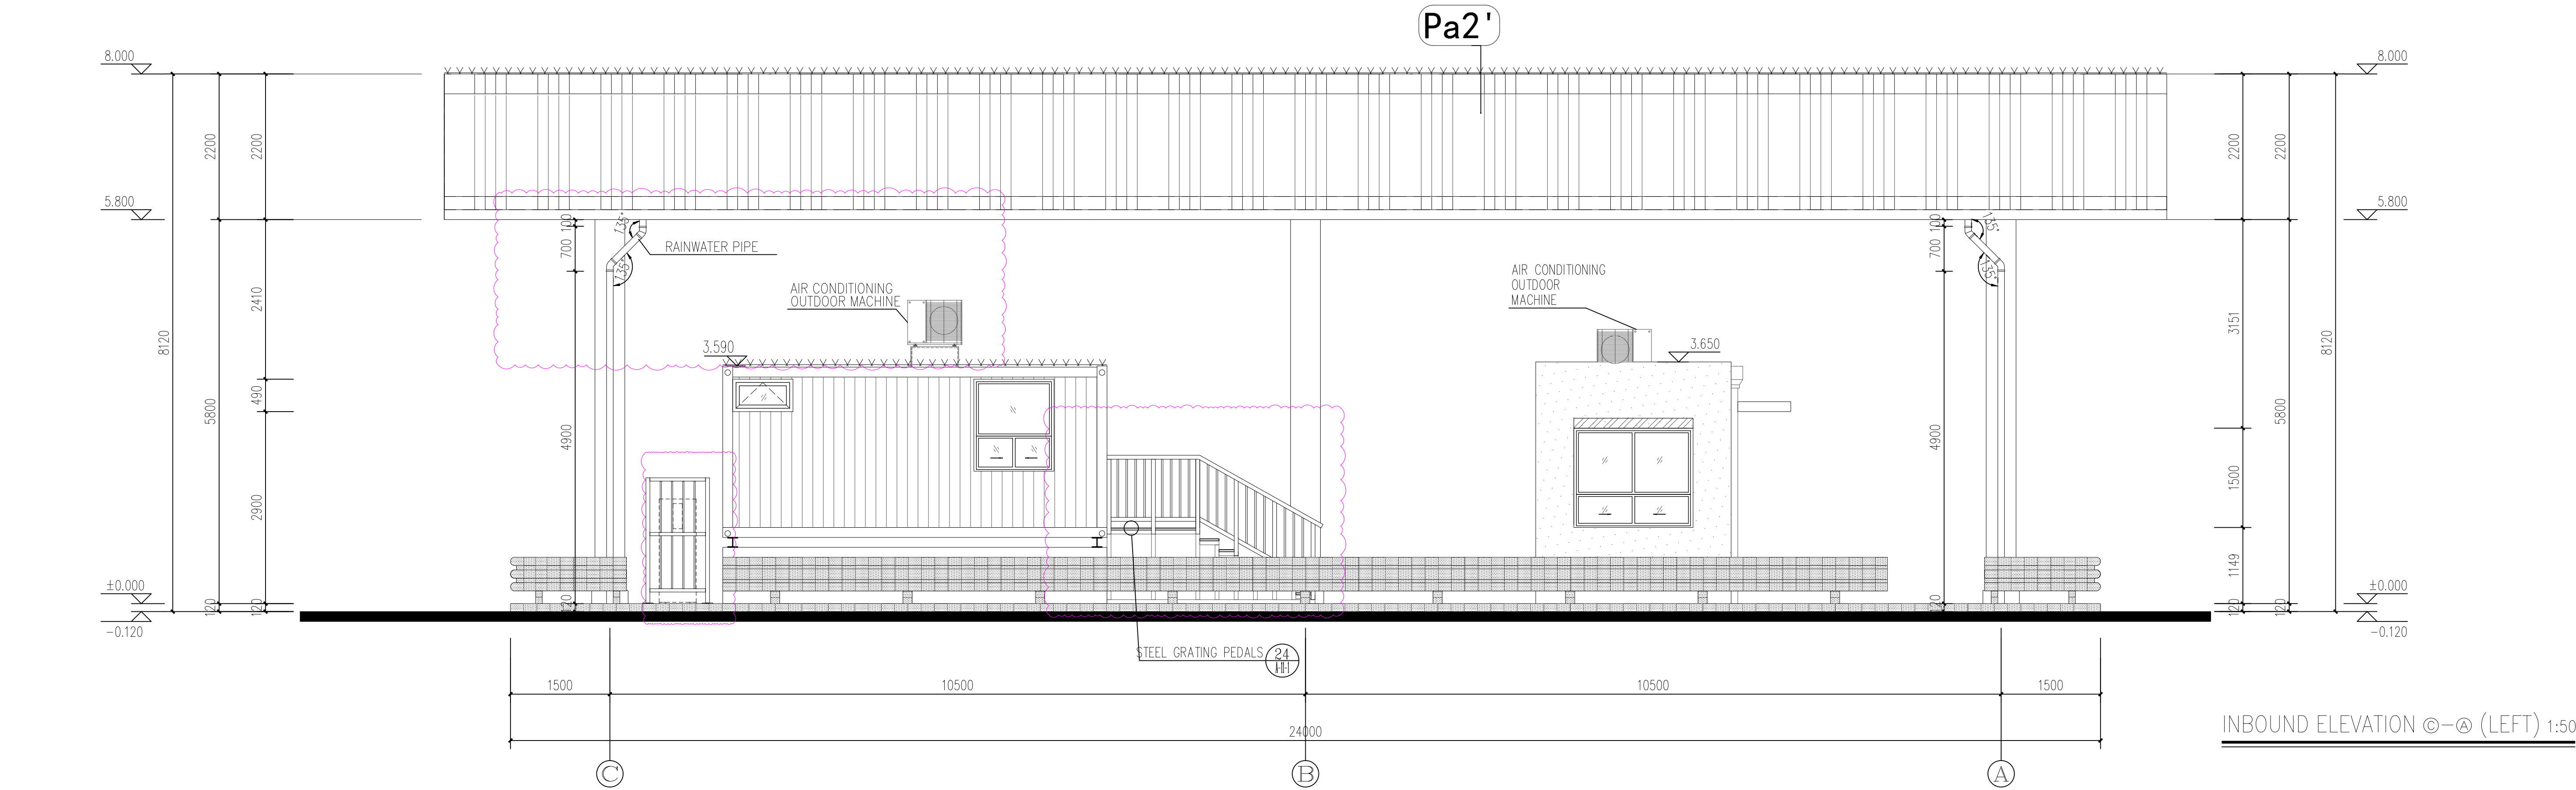

Engineer Approval Codes			
Code Nr	Condition	Signature Employer's Representative	Date
Code 1	Noted Work may proceed.		
Code 2	Noted with comments Work may proceed.		
Code 3	Rejected Work may not proceed. Revise and resubmit.		

REVISION	DESCRIPTION	DATE	CHECKED
01	Revised according to RAD-CRBC-136(ARCH Part)	22/03/2025	李明
00	First Submittals	20/12/2024	李明

EMPLOYER

PORTO DE
CAIO
CABINDA

Caioport S.A.
Avenida Comandante Gika n°150
CP 1276 Sagrada Familia
Luanda, Angola

EMPLOYER'S REPRESENTATIVE/ENGINEER

Sellhorn Ingenieurgesellschaft mbH
Teilefeld 5, D-20459 Hamburg, Germany
Tel: +49 (40) 36 12 01-0
Fax: +49 (40) 36 12 01-28
E-Mail: info@sellhorn-hamburg.de
www.sellhorn-hamburg.de

CONSULTANT

Sellhorn Ingenieurgesellschaft mbH
Teilefeld 5, D-20459 Hamburg, Germany
Tel: +49 (40) 36 12 01-0
Fax: +49 (40) 36 12 01-28
E-Mail: info@sellhorn-hamburg.de
www.sellhorn-hamburg.de

CONTRACTOR

China Road and Bridge Corporation
R. Femeu Mendes Pinto 55
Anadia, Luanda, Angola
Fax: +244 22 232 7003
http://www.crbc.com/

PROJECT

The Project of the New Port of Caio in Cabinda

DRAWING TITLE

Onshore Buildings_Main Gate
Inbound Elevations (1)

DESIGNED BY	DRAWN BY	CHECKED BY	SCALE	DRAWING N°
20/03/2025	20/03/2025	22/03/2025	1:50	LOT1_DD_1020-A-05
NAME	李明	李明		
DESIGN STAGE	DETAILED DESIGN			