


**NOTE:**  
ALL DIMENSIONS SHOWN IN THE DRAWING ARE IN MILLIMETER (MM), AND ALL LEVELS OR ELEVATIONS ARE IN METER (M) UNLESS OTHERWISE SPECIFIED.

LEGENDS:	
	PROFILED STEEL SHEET (RAL 9006)
	PAINT SPRAYING (RAL 9006)
	EXTERIOR WALL OF OFFICE CONTAINER (RAL 9006)
	SIGNALING PAINT (RAL 9004 AND RAL 1003)
	CONCRETE
	STAINLESS STEEL BIRD PROTECTION

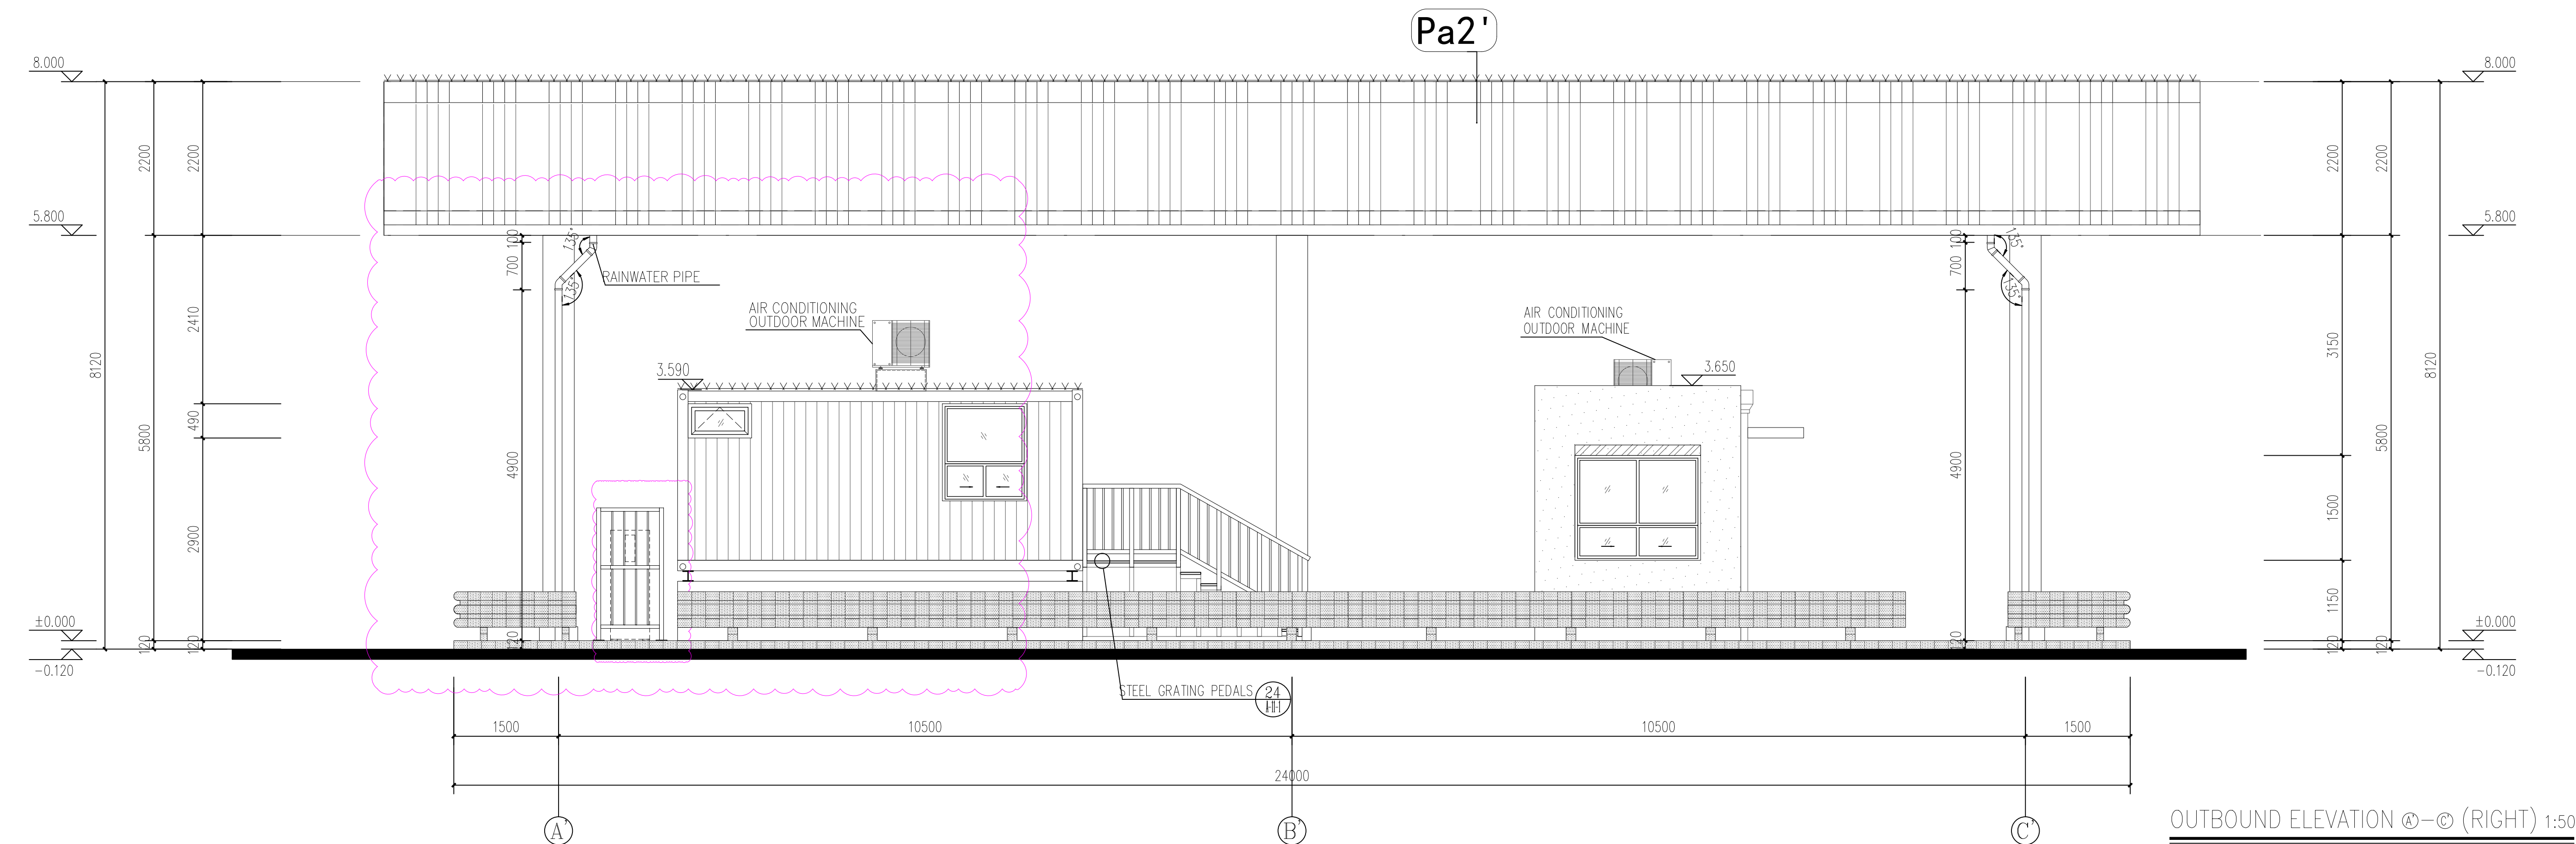

Engineer Approval Codes			
Code Nr	Condition	Signature Employer's Representative	Date
Code 1	Noted Work may proceed.		
Code 2	Noted with comments Work may proceed.		
Code 3	Rejected Work may not proceed. Revise and resubmit.		

01	Revised according to RAD-CRBC-136(ARCH Part)	22/03/2025	
00	First Submittals	20/12/2024	
REVISION	DESCRIPTION	DATE	CHECKED

EMPLOYER	 <b>PORTO DE CAIO CABINDA</b>	<b>Caioporto S.A.</b> Avenida Comandante Gika n°150 CP 1276 Sagrada Família Luanda, Angola
EMPLOYER'S REPRESENTATIVE/ENGINEER	 <b>Sellhorn</b> INGENIEURGESELLSCHAFT	 <b>HPC</b>
CONSULTANT	 <b>Sellhorn</b> INGENIEURGESELLSCHAFT	 <b>HPC</b>
CONTRACTOR	 <b>RB</b>	China Road and Bridge Corporation R. Fernus Avenida Pinto 55 Avenida, Luanda, Angola Fax: +244 22 232 7003 http://www.crbc.com/

PROJECT		The Project of the New Port of Caio in Cabinda	
DRAWING TITLE		Onshore Buildings_Main Gate Outbound Elevations (2)	
DESIGNED BY	DRAWN BY	CHECKED BY	SCALE
DATE	20/03/2025	20/03/2025	22/03/2025
NAME			
DESIGN STAGE	DETAILED DESIGN		

DATE	20/03/2025	20/03/2025	22/03/2025	SCALE	1:50	DRAWING N°	LOT1_DD_1020-A-09-1
NAME							