


NOTE:
ALL DIMENSIONS SHOWN IN THE DRAWING ARE IN MILLIMETER (MM), AND ALL LEVELS OR ELEVATIONS ARE IN METER (M) UNLESS OTHERWISE SPECIFIED.


LEGENDS:	
	PROFILED STEEL SHEET (RAL 9006)
	PAINT SPRAYING (RAL 9006)
	EXTERIOR WALL OF OFFICE CONTAINER (RAL 9006)
	SIGNALING PAINT (RAL 9004 AND RAL 1003)
	CONCRETE
	STAINLESS STEEL BIRD PROTECTION

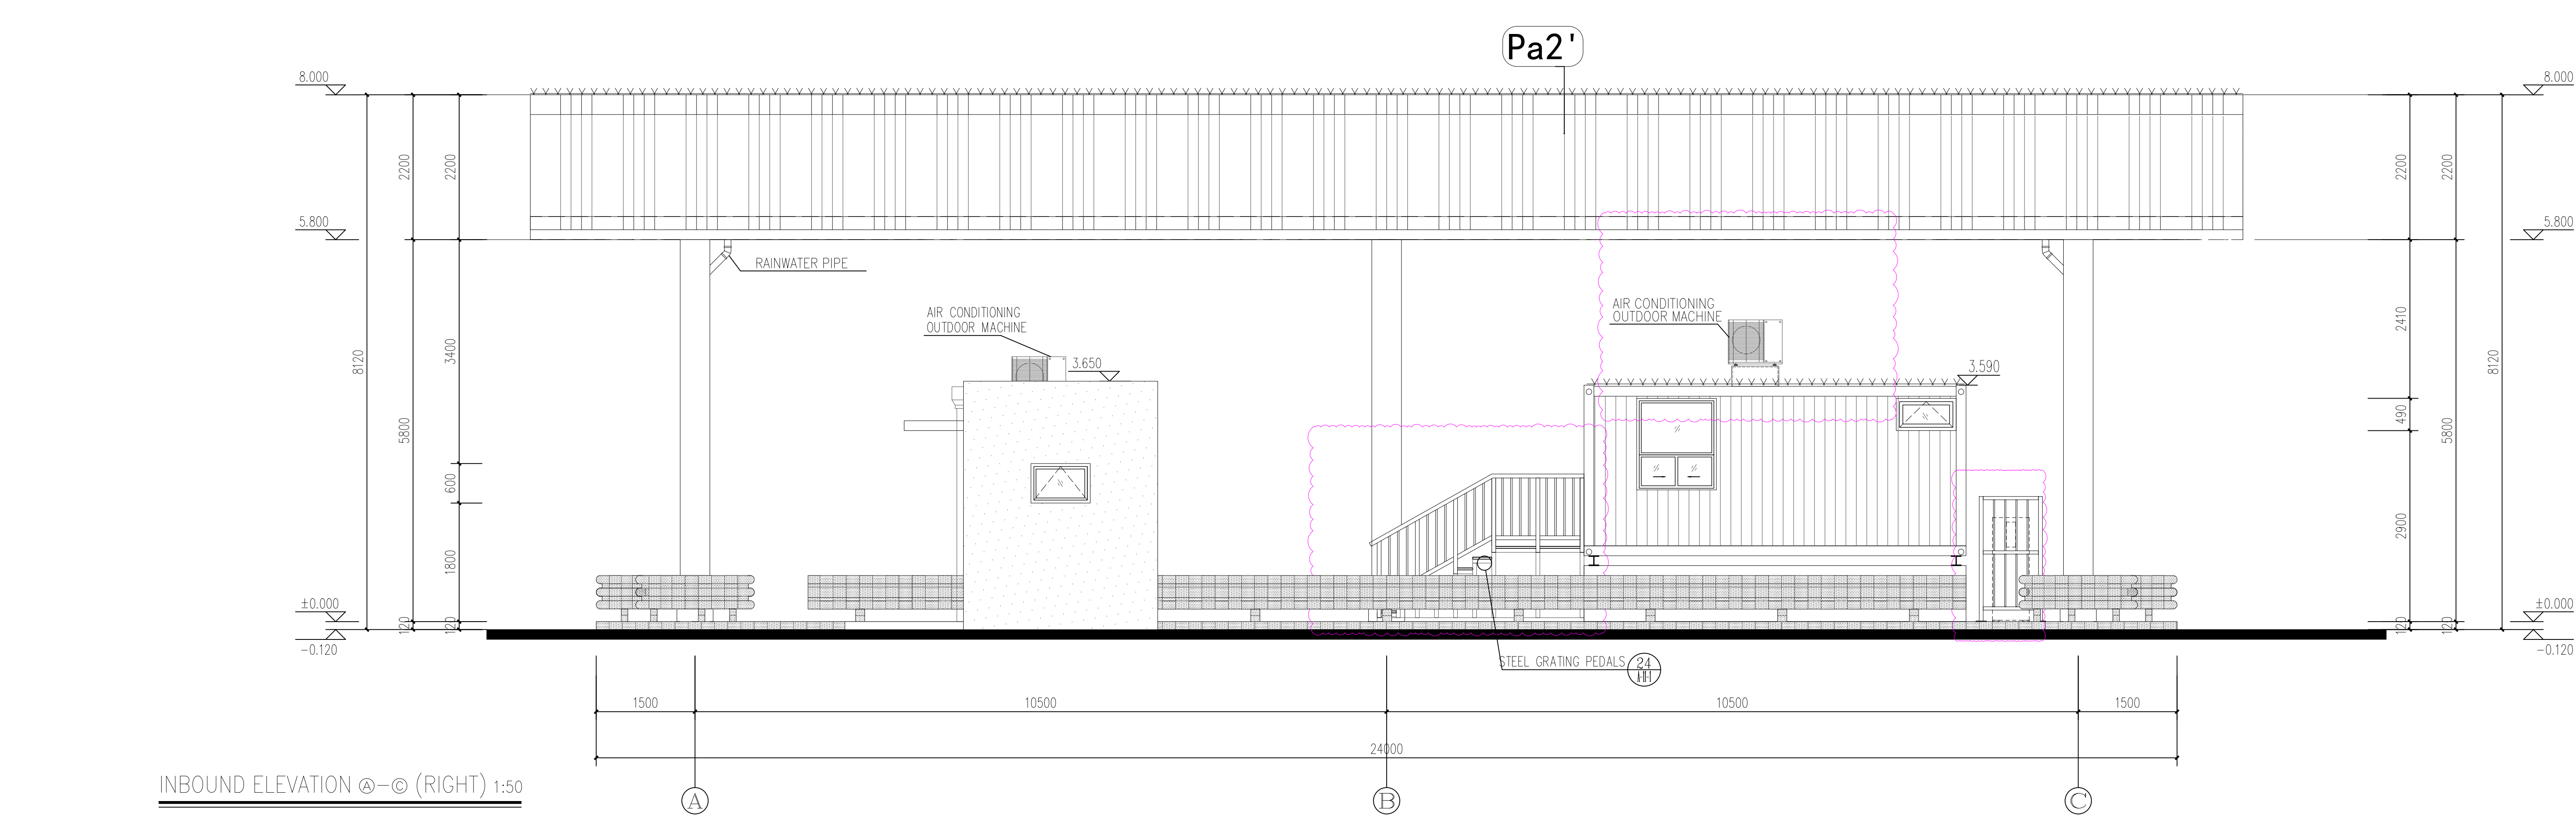

Engineer Approval Codes			
Code Nr	Condition	Signature Employer's Representative	Date
Code 1	Noted Work may proceed.		
Code 2	Noted with comments Work may proceed.		
Code 3	Rejected Work may not proceed. Revise and resubmit.		

01	Revised according to RAD-CRBC-136(ARCH Part)	22/03/2025	陈明
00	First Submittals	20/12/2024	陈明
REVISION	DESCRIPTION	DATE	CHECKED



EMPLOYER



PORTO DE
CAIO
CABINDA



Caioporto S.A.
Avenida Comandante Gika n°150
CP 1276 Sagrada Família
Luanda, Angola

EMPLOYER'S REPRESENTATIVE/ENGINEER




Sellhorn Ingenieurgesellschaft mbH
Telfelk S. D-20459 Hamburg, Germany
Tel: +49 (40) 36 12 01-0
Fax: +49 (40) 36 12 01-28
E-Mail: info@sellhorn-hamburg.de
www.sellhorn-hamburg.de

CONSULTANT



Sellhorn Ingenieurgesellschaft mbH
Telfelk S. D-20459 Hamburg, Germany
Tel: +49 (40) 36 12 01-0
Fax: +49 (40) 36 12 01-28
E-Mail: info@sellhorn-hamburg.de
www.sellhorn-hamburg.de

CONTRACTOR



China Road and Bridge Corporation
R. Femenio Mendes Pinto 55
Avenida, Luanda, Angola
Fax: +244 22 232 7003
http://www.crbc.com/

PROJECT

The Project of the New Port of Caio in Cabinda

DRAWING TITLE

Onshore Buildings_Main Gate
Inbound Elevations (2)

	DESIGNED BY	DRAWN BY	CHECKED BY	SCALE	DRAWING N°
DATE	20/03/2025	20/03/2025	22/03/2025	1:50	LOT1_DD_1020-A-05-1
NAME	陈明	陈明	陈明		
DESIGN STAGE	DETAILED DESIGN				