



NOTE:
ALL DIMENSIONS SHOWN IN THE DRAWING ARE IN MILLIMETER (MM), AND ALL LEVELS OR ELEVATIONS ARE IN METER (M) UNLESS OTHERWISE SPECIFIED.

LEGENDS:


 PROFILED STEEL SHEET (RAL 9006)

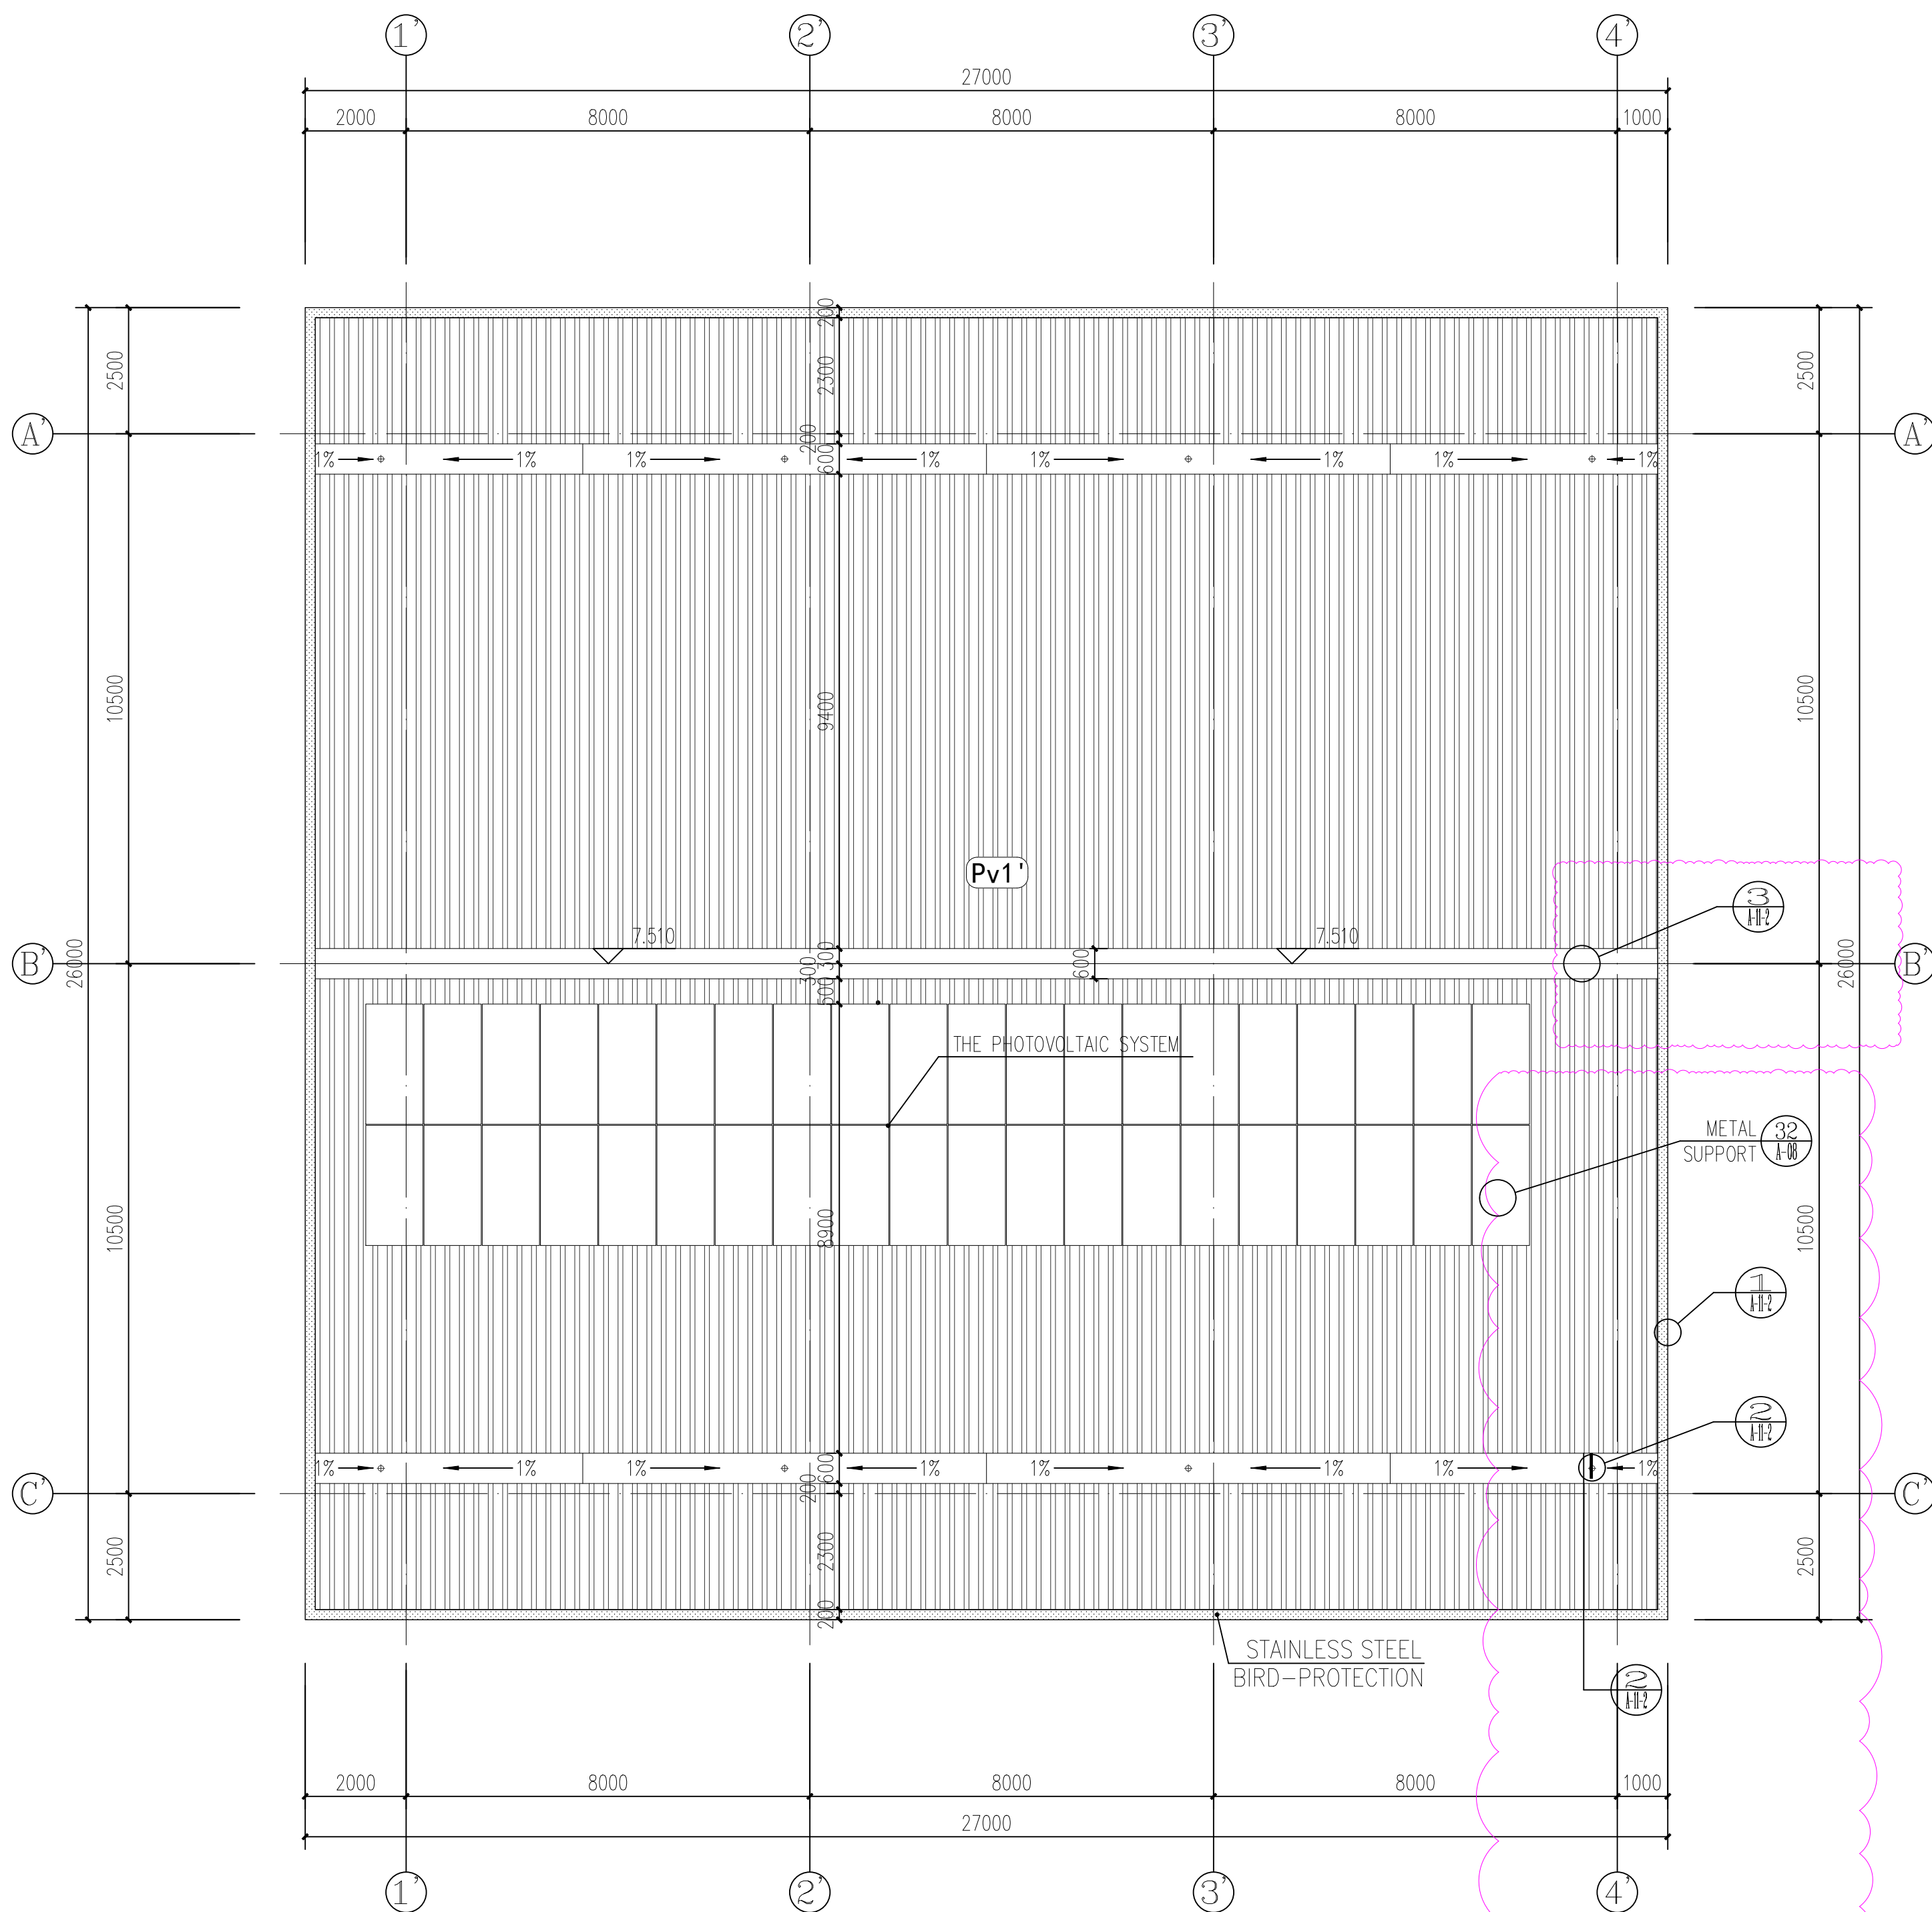

ROOF OUTBOUND PLAN 1:100

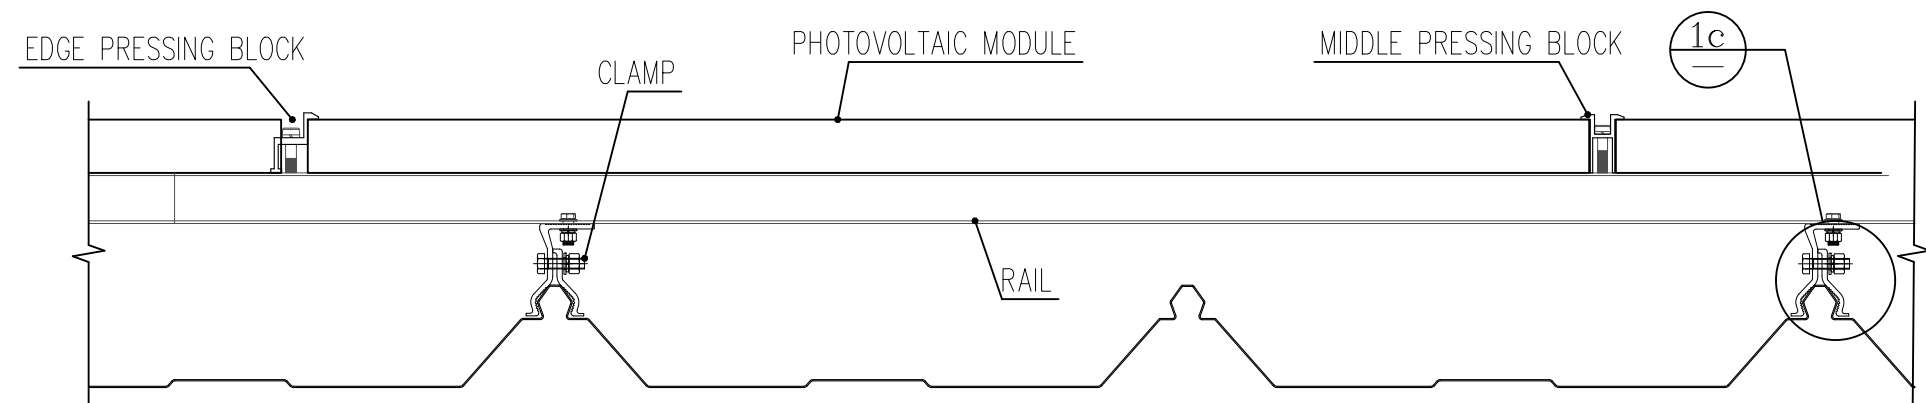

32 METAL SUPPORT FOR SOLAR PANELS DETAILS 1:20

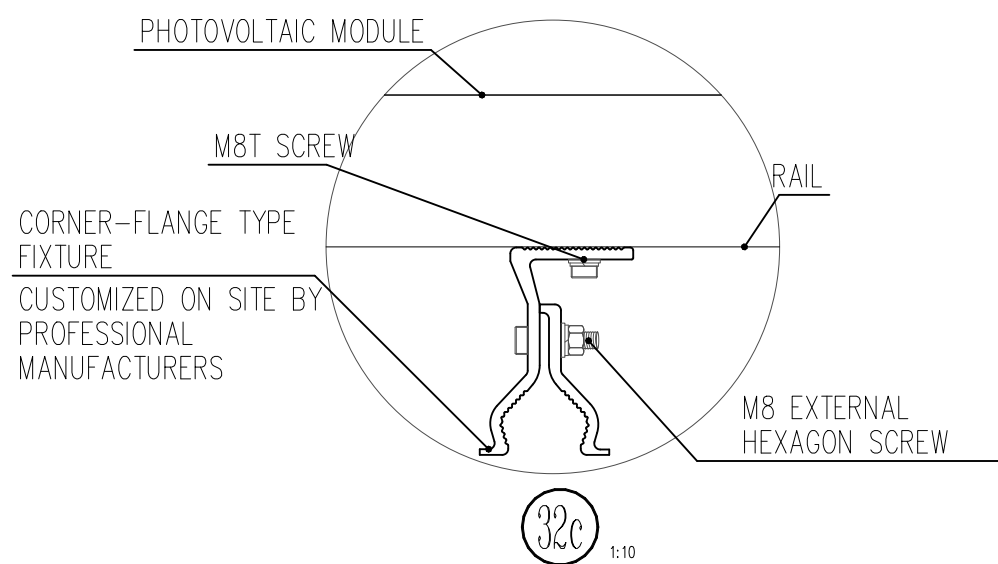

NOTES:
SOLAR PANELS SUPPORTS WILL BE PREPARED AND DETAILED BY THE SUPPLIER, AND ITS METAL COMPONENTS SHOULD MEET THE C5 CORROSION RESISTANCE REQUIREMENTS, WITH THICKNESS OF ANTI-CORROSION PAINT NDT ≥ 240μm, INCLUDING 70μm OF PRIMER, 70μm OF INTERMEDIATE COATING, AND 100μm OF FINAL COATING. FASTENERS SHOULD BE EFFECTIVELY SECURED AND FIRMLY FIXED. THE WATERPROOF LEVEL AND PERFORMANCE OF SEALING COMPONENTS OF SOLAR SUPPORTS SHOULD BE CONSISTENT WITH THAT OF THE ROOF, AND THE ORIGINAL WATERPROOF SYSTEM SHOULD NOT BE DAMAGED.

Engineer Approval Codes

Code Nr	Condition	Signature Employer's Representative	Date
Code 1	Noted Work may proceed.		
Code 2	Noted with comments Work may proceed.		
Code 3	Rejected Work may not proceed. Revise and resubmit.		

REVISION	DESCRIPTION	DATE	CHECKED
01	Revised according to RAD-CRBC-136(ARCH Part)	22/03/2025	李明
00	First Submittals	20/12/2024	李明

EMPLOYER	 PORTO DE CAIO CABINDA	Caioport S.A. Avenida Comandante Gika n º150 CP 1276 Sagrada Família Luanda, Angola
EMPLOYER'S REPRESENTATIVE/ENGINEER	 	Sellhorn Ingenieurgesellschaft mbH Tiefelfeld 5, D-20459 Hamburg, Germany Tel: +49 (40) 36 12 01-0 Fax: +49 (40) 36 12 01-28 E-Mail: info@sellhorn-hamburg.de www.sellhorn-hamburg.de
CONSULTANT	 	Sellhorn Ingenieurgesellschaft mbH Tiefelfeld 5, D-20459 Hamburg, Germany Tel: +49 (40) 36 12 01-0 Fax: +49 (40) 36 12 01-28 E-Mail: info@sellhorn-hamburg.de www.sellhorn-hamburg.de
CONTRACTOR		China Road and Bridge Corporation R. Femenao Mendes Pinto 55 Avalade, Luanda, Angola Fax: +244 22 232 7003 http://www.crbc.com/

PROJECT

The Project of the New Port of Caio in Cabinda

DRAWING TITLE

Onshore Buildings_Main Gate
Roof Outbound Plan

	DESIGNED BY	DRAWN BY	CHECKED BY	SCALE	DRAWING N°
DATE	20/03/2025	20/03/2025	22/03/2025	1:100	LOT1_DD_1020-A-08
NAME	李明	李明	李明		
DESIGN STAGE	DETAILED DESIGN				