




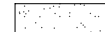
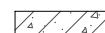

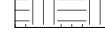
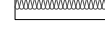
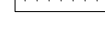

ELEVATION ①-④ 1:50





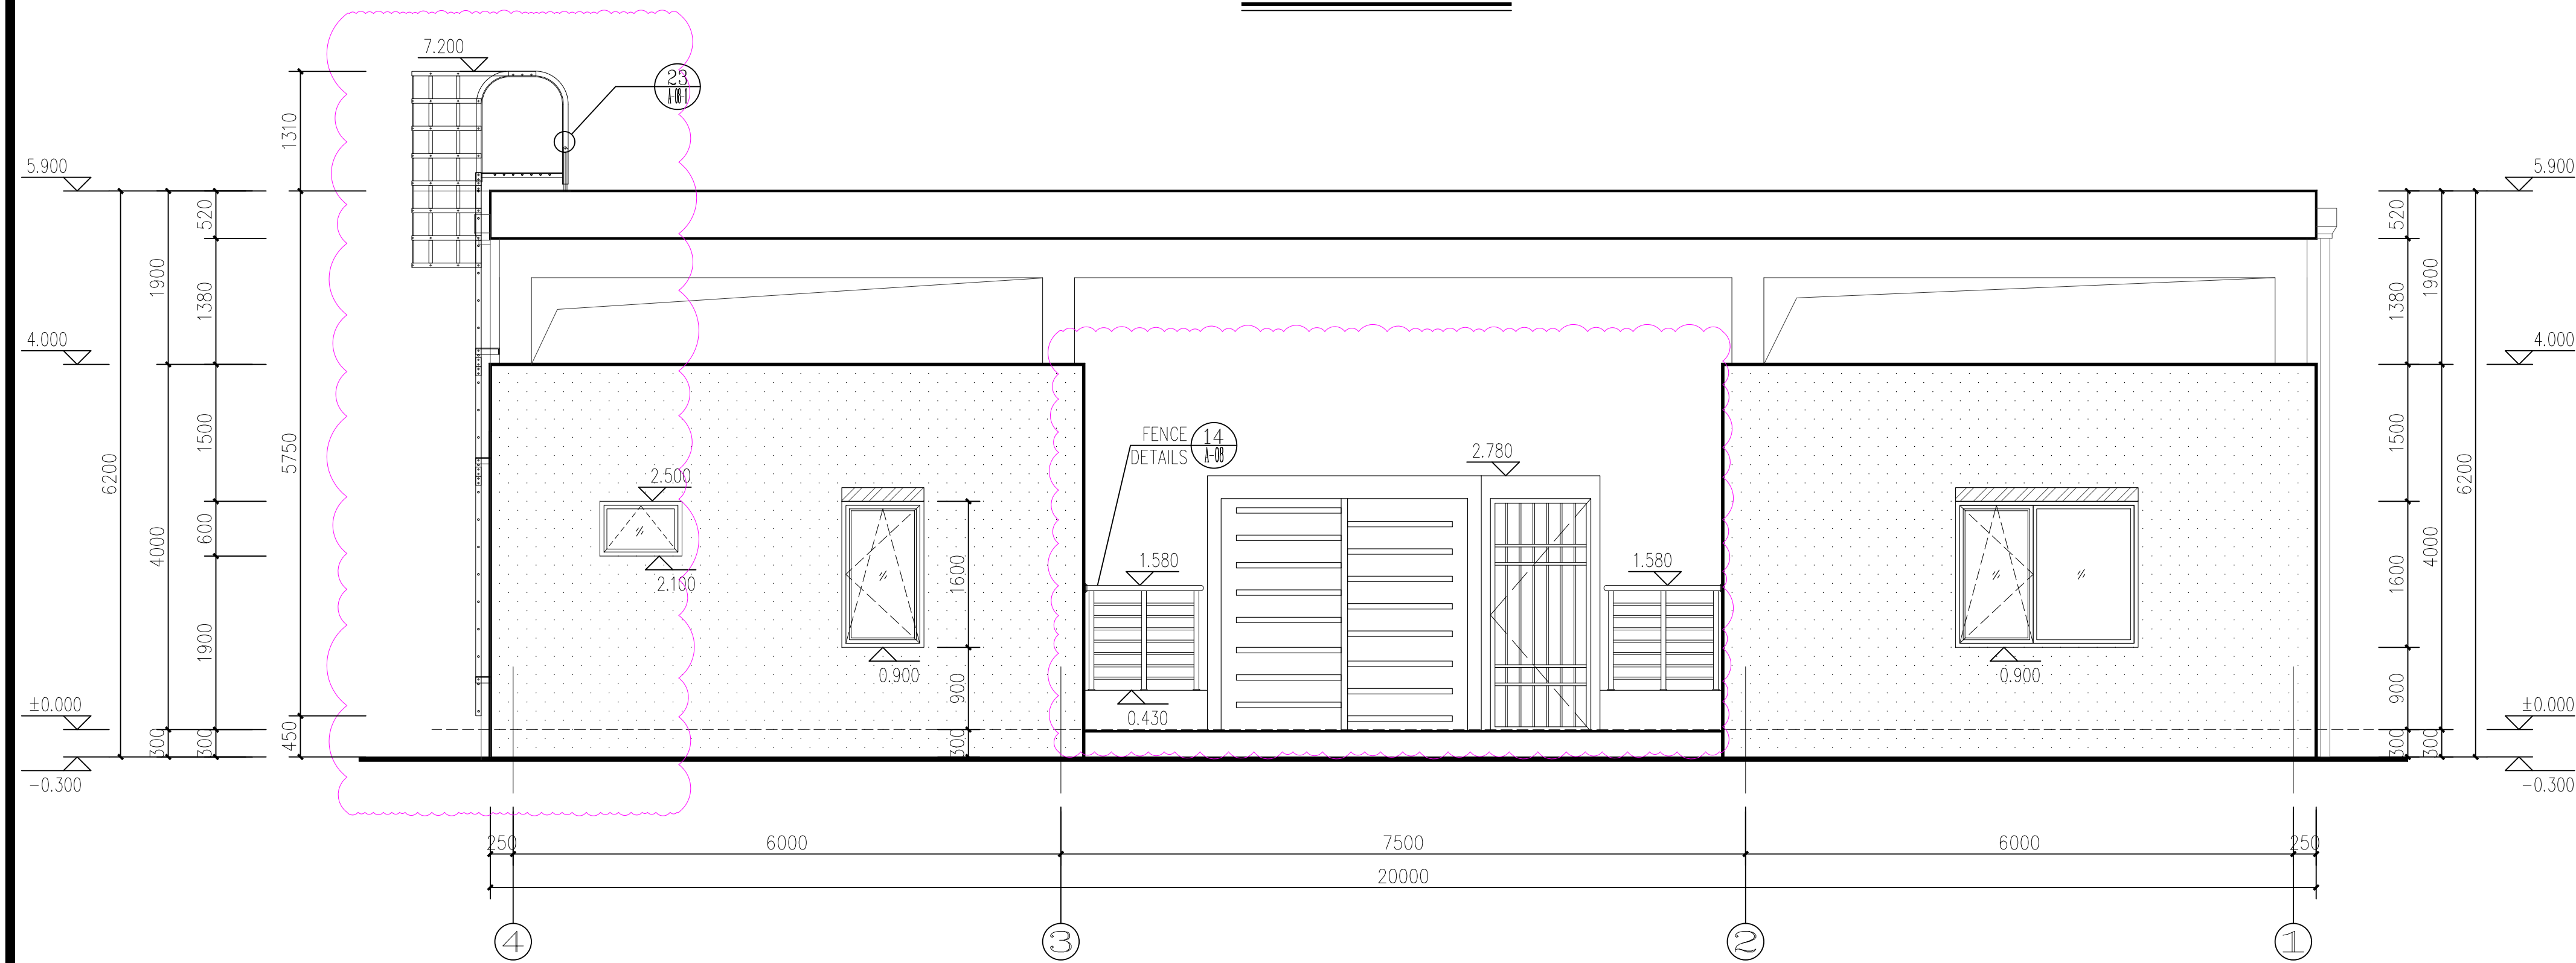

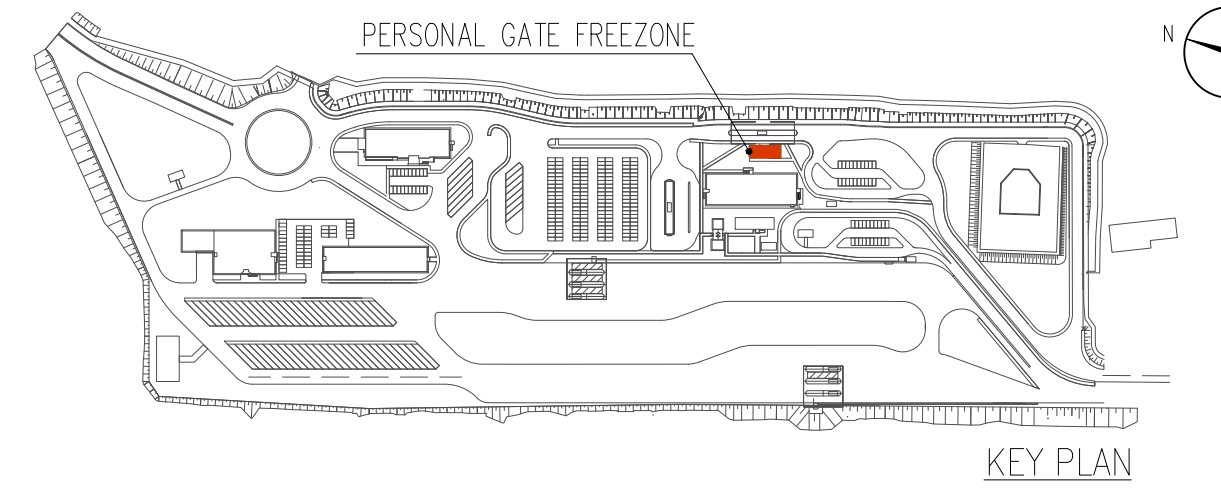

ELEVATION ④-① 1:50



NOTE:
ALL DIMENSIONS SHOWN IN THE DRAWING ARE IN MILLIMETER (MM), AND ALL LEVELS OR ELEVATIONS ARE IN METER (M) UNLESS OTHERWISE SPECIFIED.

LEGENDS		
	RAL 9016	RAL COLOR SYSTEM
	RAL 7036	
	REINFORCED CONCRETE	
	CONCRETE	
	RAMMED EARTH	
	ROCK WOOL BOARD	
	EXTERIOR WALL OF OFFICE CONTAINER (RAL 9016)	
	CONCRETE HOLLOW BRICK	

Engineer Approval Codes			
Code Nr	Condition	Signature Employer's Representative	Date
Code 1	Noted Work may proceed.		
Code 2	Noted with comments Work may proceed.		
Code 3	Rejected Work may not proceed. Revise and resubmit.		
01	Revised according to RAD-CRBC-135(ARCH Part)	23/03/2025	✓ - 明
00	First Submittals	20/12/2024	✓ - 明
REVISION	DESCRIPTION	DATE	CHECKED
EMPLOYER		Caioport S.A. Avenida Comandante Gika n °150 CP 1276 Sagrada Família Luanda, Angola	
 PORTO DE CAIO CABINDA			
EMPLOYER'S REPRESENTATIVE/ENGINEER		Sellhorn Ingenieurgesellschaft mbH Tiefeld 5, D-20459 Hamburg, Germany Tel: +49 (40) 36 12 01-0 Fax: +49 (40) 36 12 01-28 E-Mail: info@sellhorn-hamburg.de www.sellhorn-hamburg.de	
 			
CONSULTANT		Sellhorn Ingenieurgesellschaft mbH Tiefeld 5, D-20459 Hamburg, Germany Tel: +49 (40) 36 12 01-0 Fax: +49 (40) 36 12 01-28 E-Mail: info@sellhorn-hamburg.de www.sellhorn-hamburg.de	
 			
CONTRACTOR		 China Road and Bridge Corporation R. Femao Mendes Pinto 55 Avalade, Luanda, Angola Fax: +244 22 232 7003 http://www.crbc.com/	
PROJECT			
The Project of the New Port of Caio in Cabinda			
DRAWING TITLE			
Onshore Buildings_Personal Gate Freezone Elevations			
	DESIGNED BY	DRAWN BY	CHECKED BY
DATE	20/03/2024	22/03/2024	23/03/2025
NAME	新吉	新吉	✓ - 明
DESIGN STAGE	DETAILED DESIGN		
	SCALE	DRAWING N°	
	1:50	LOT1_DD_1022-A-05	