




ELEVATION 1-2 (FRONT) 1:50

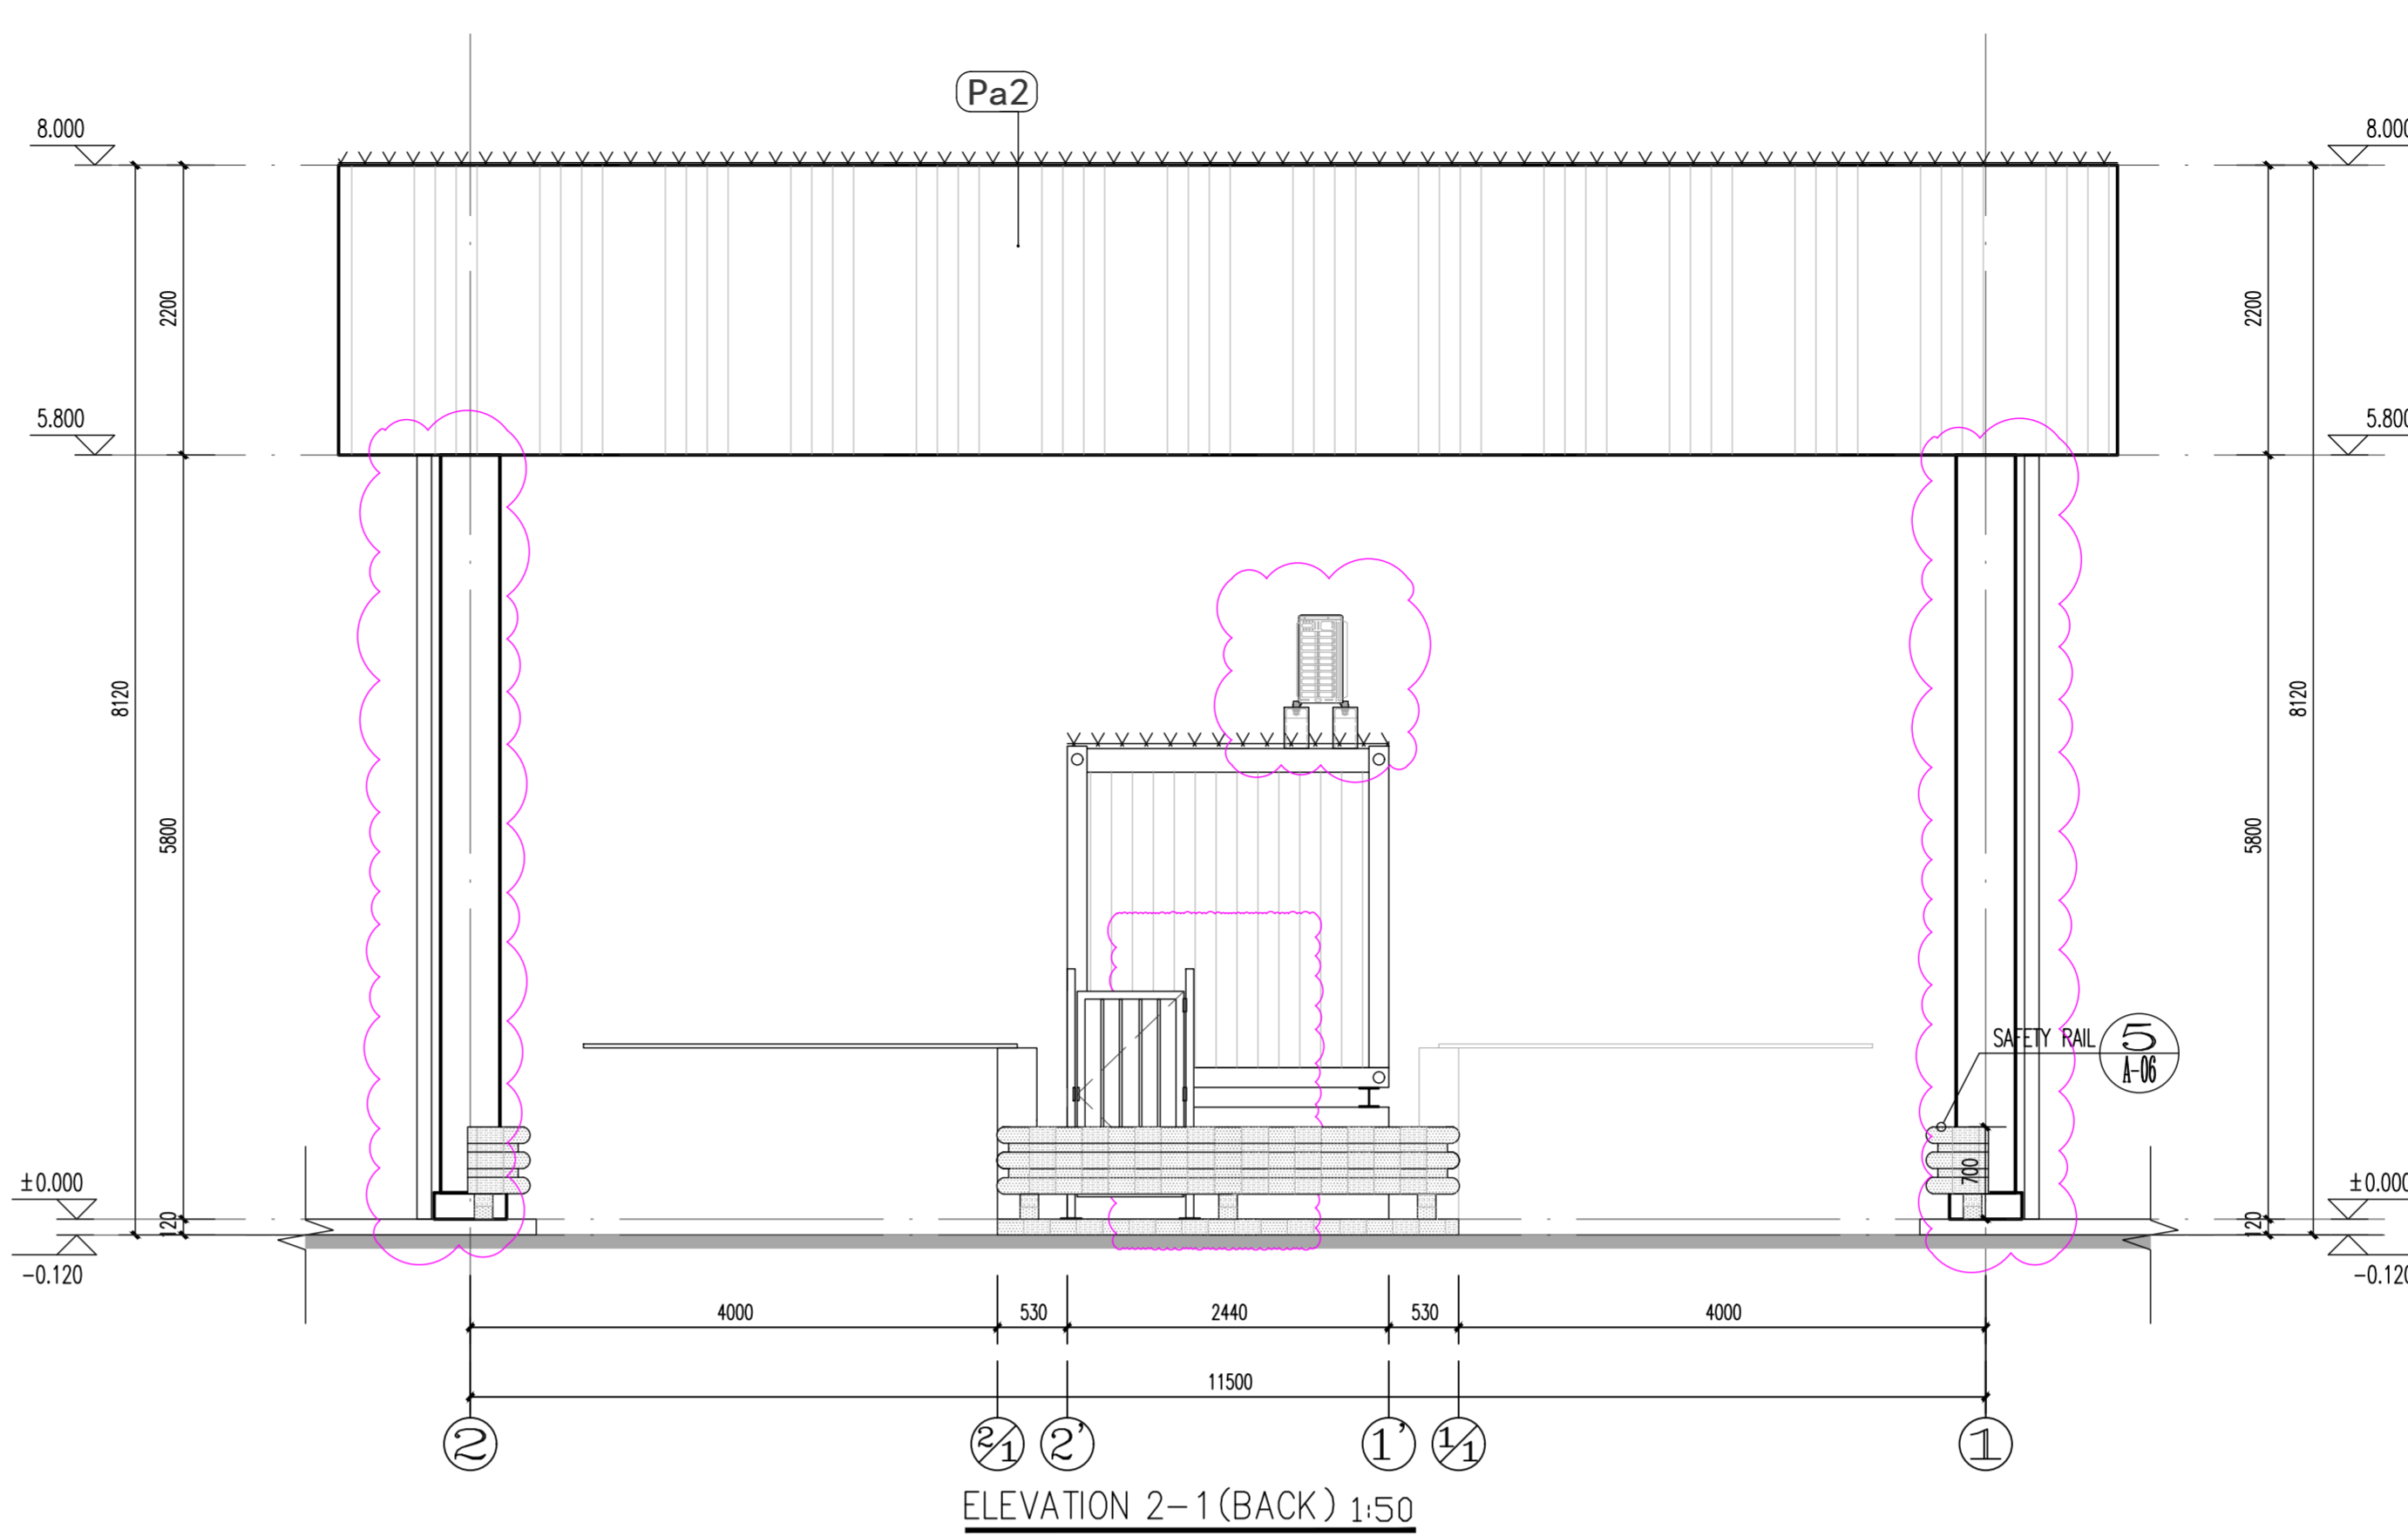


ELEVATION 2-1 (BACK) 1:50

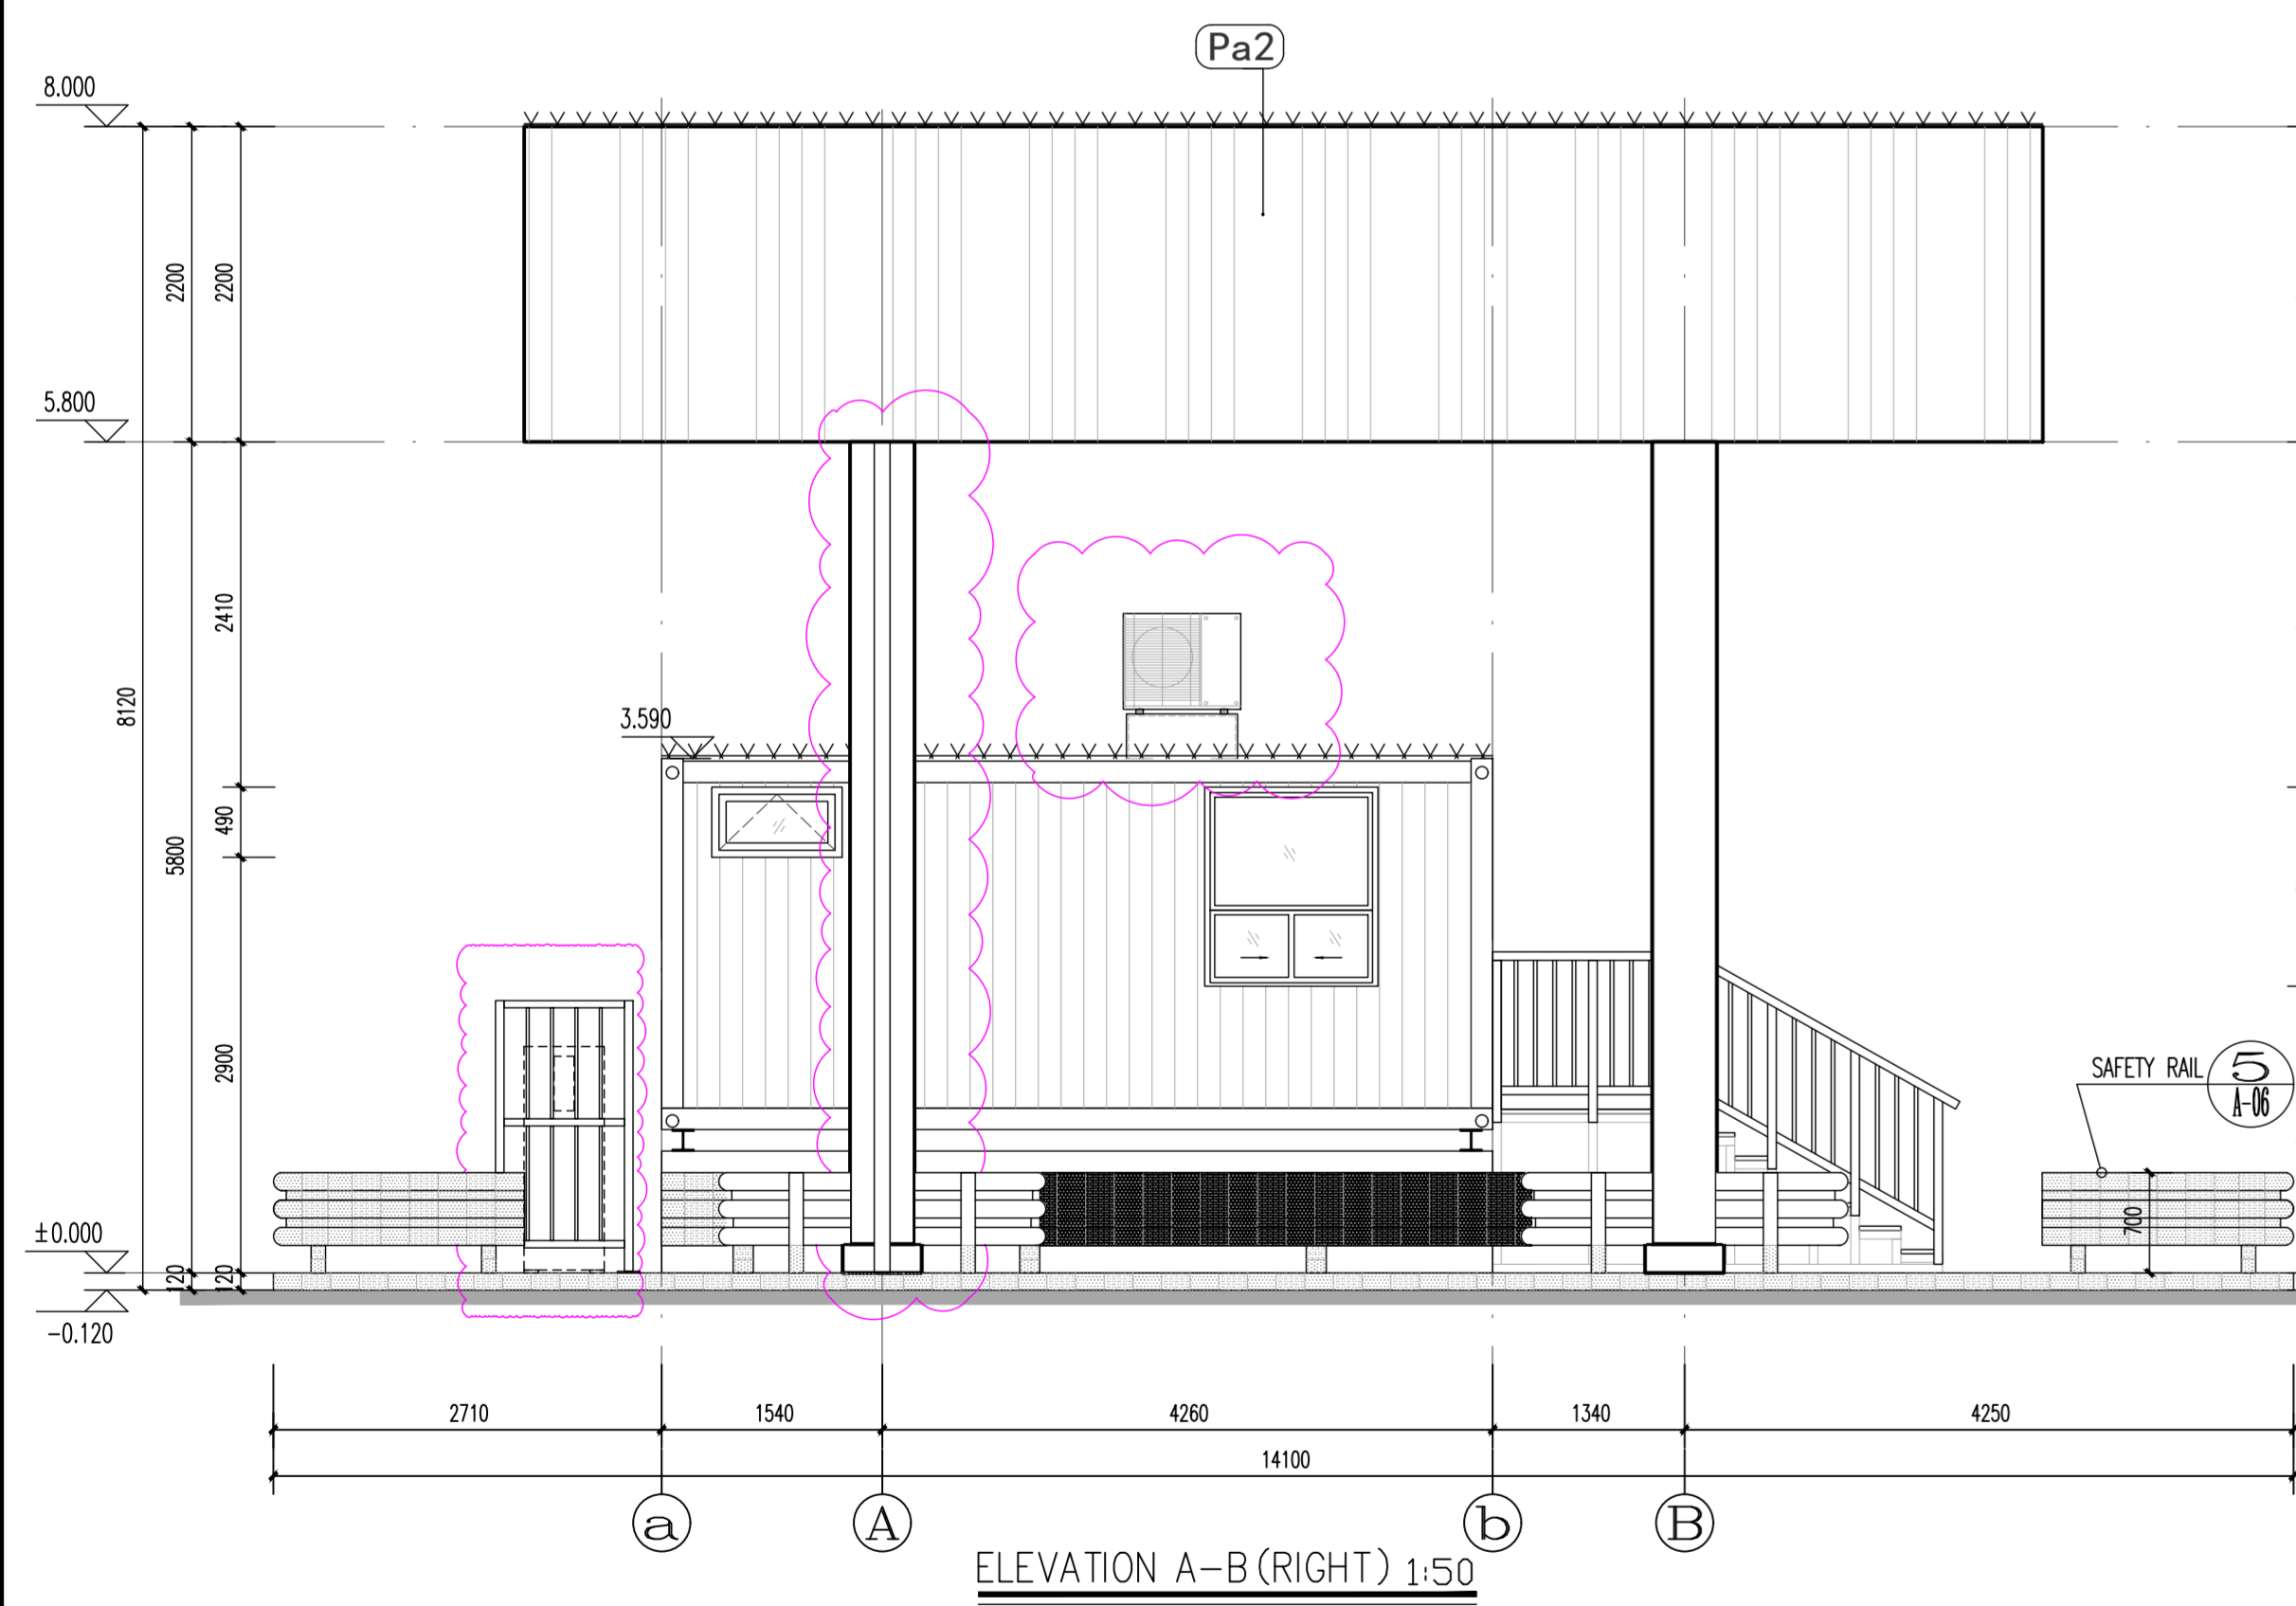


ELEVATION A-B (RIGHT) 1:50

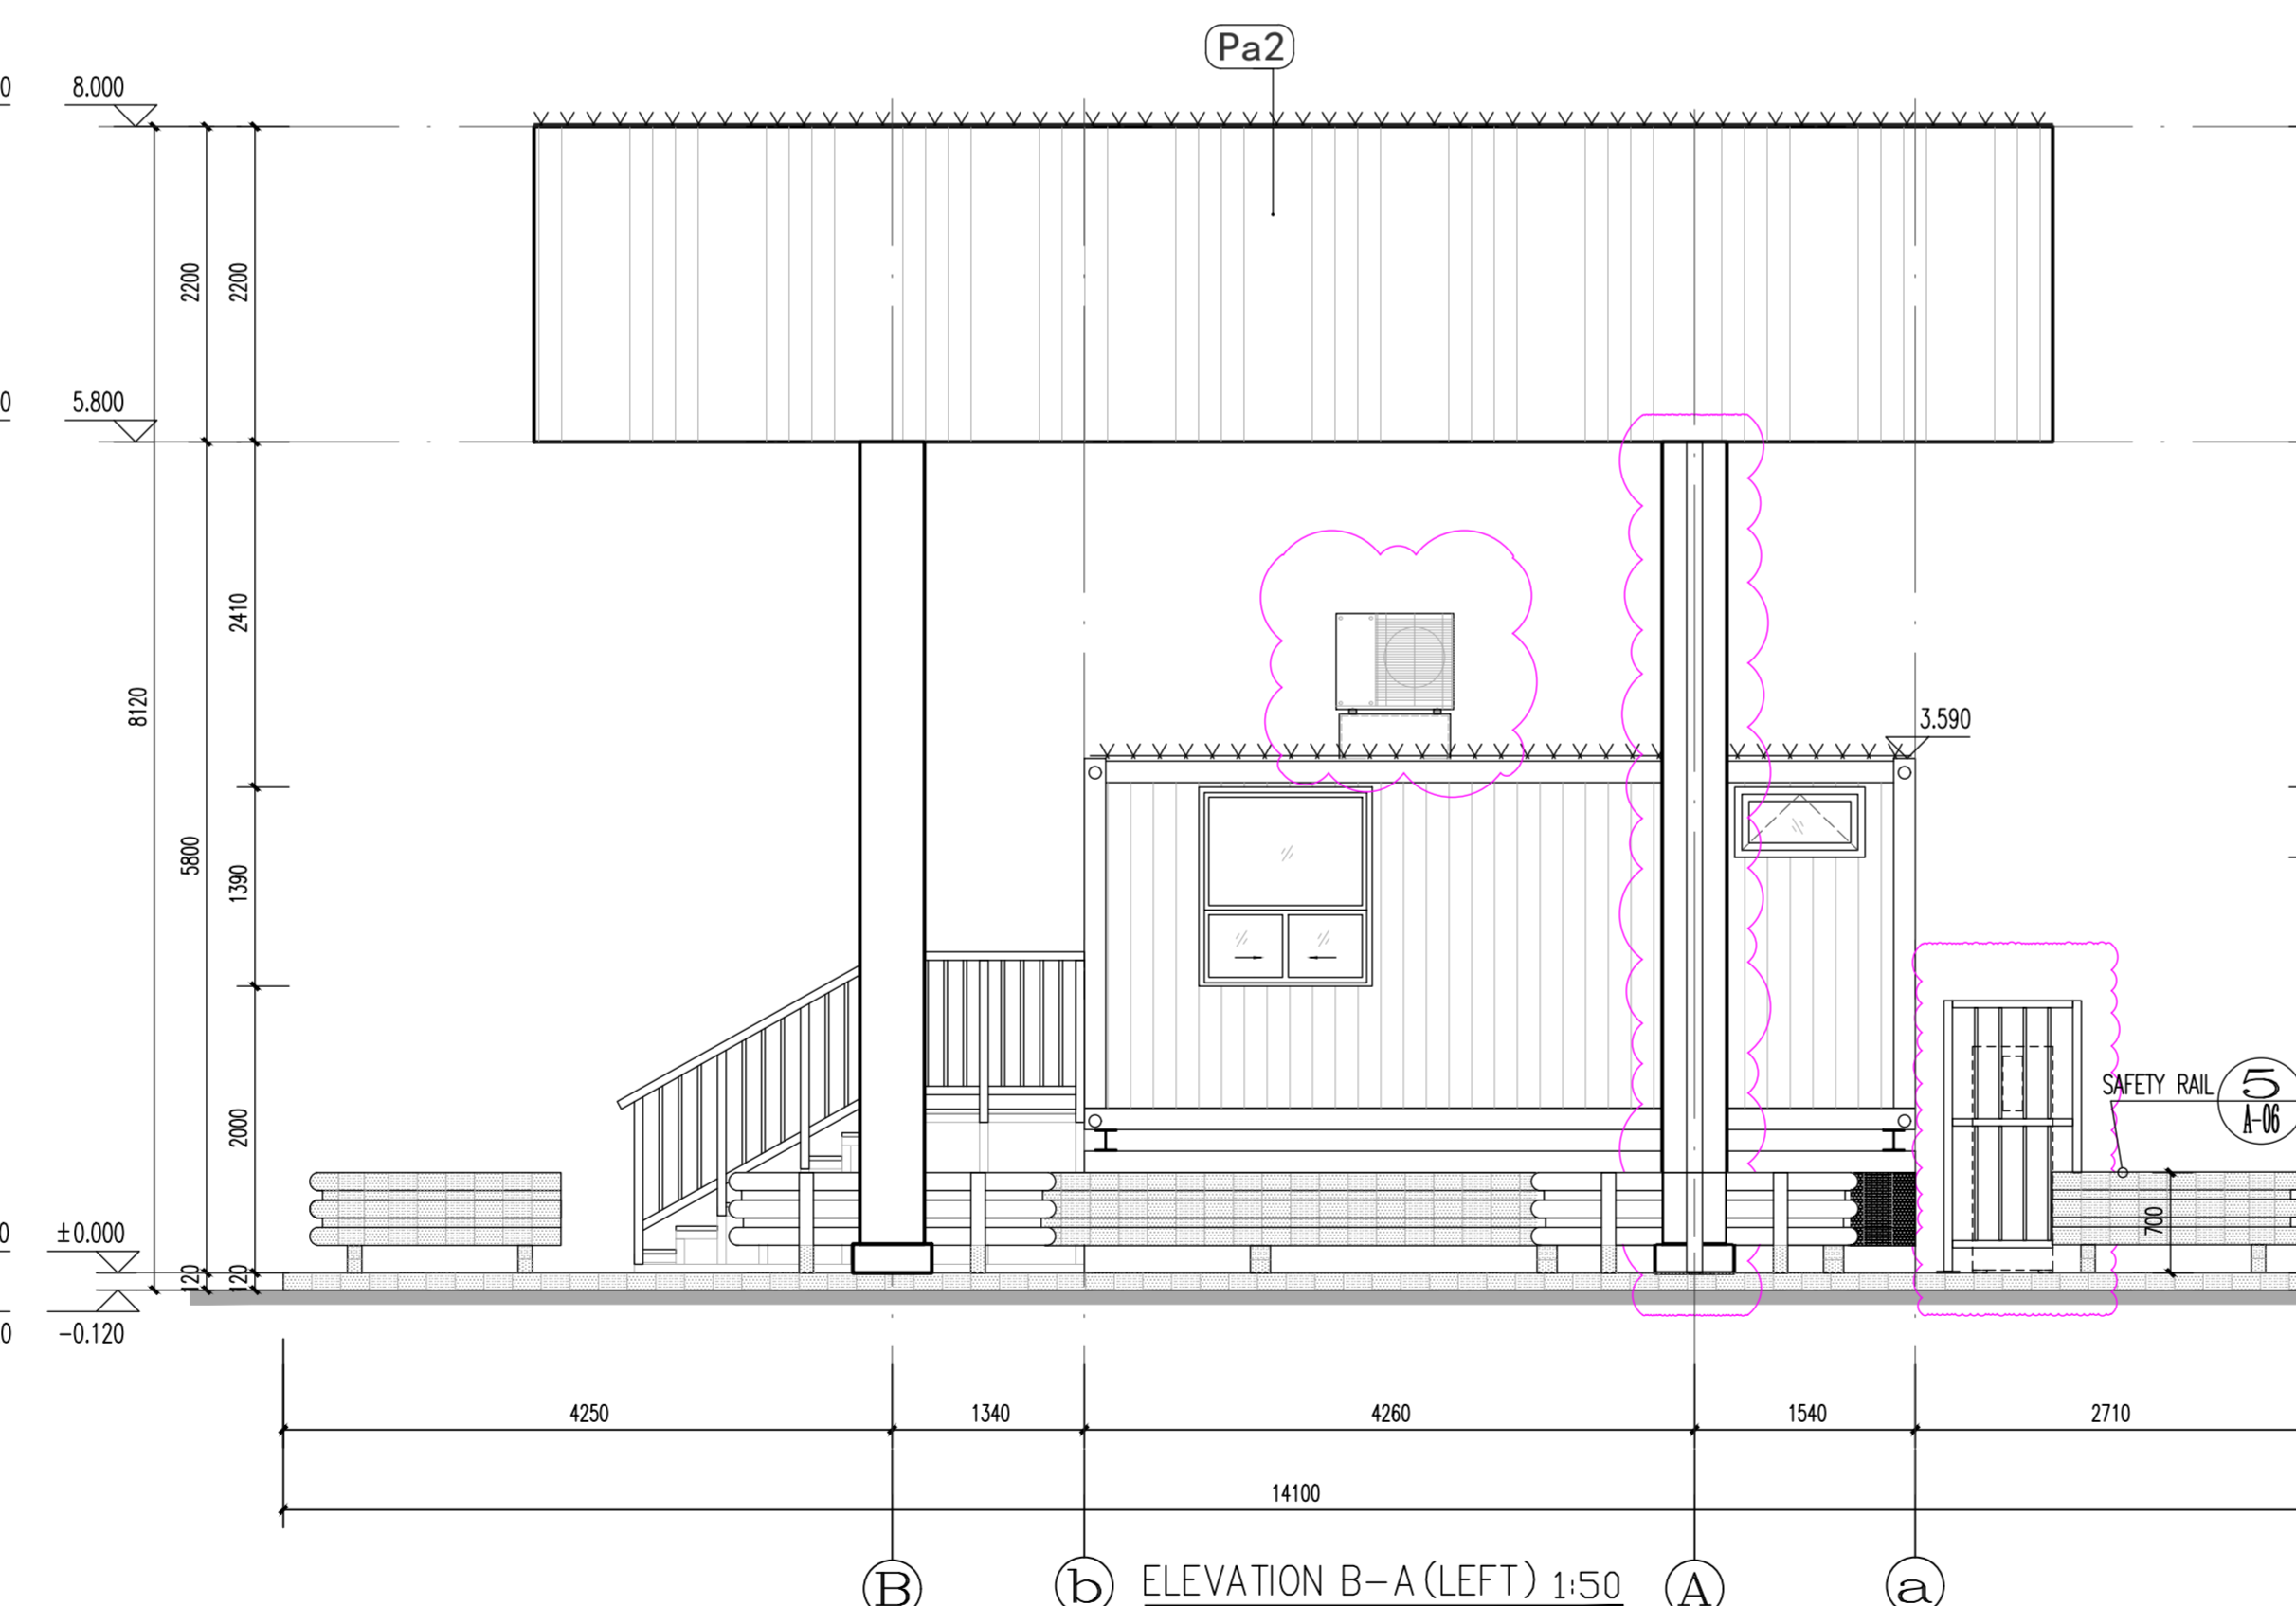

ELEVATION B-A (LEFT) 1:50

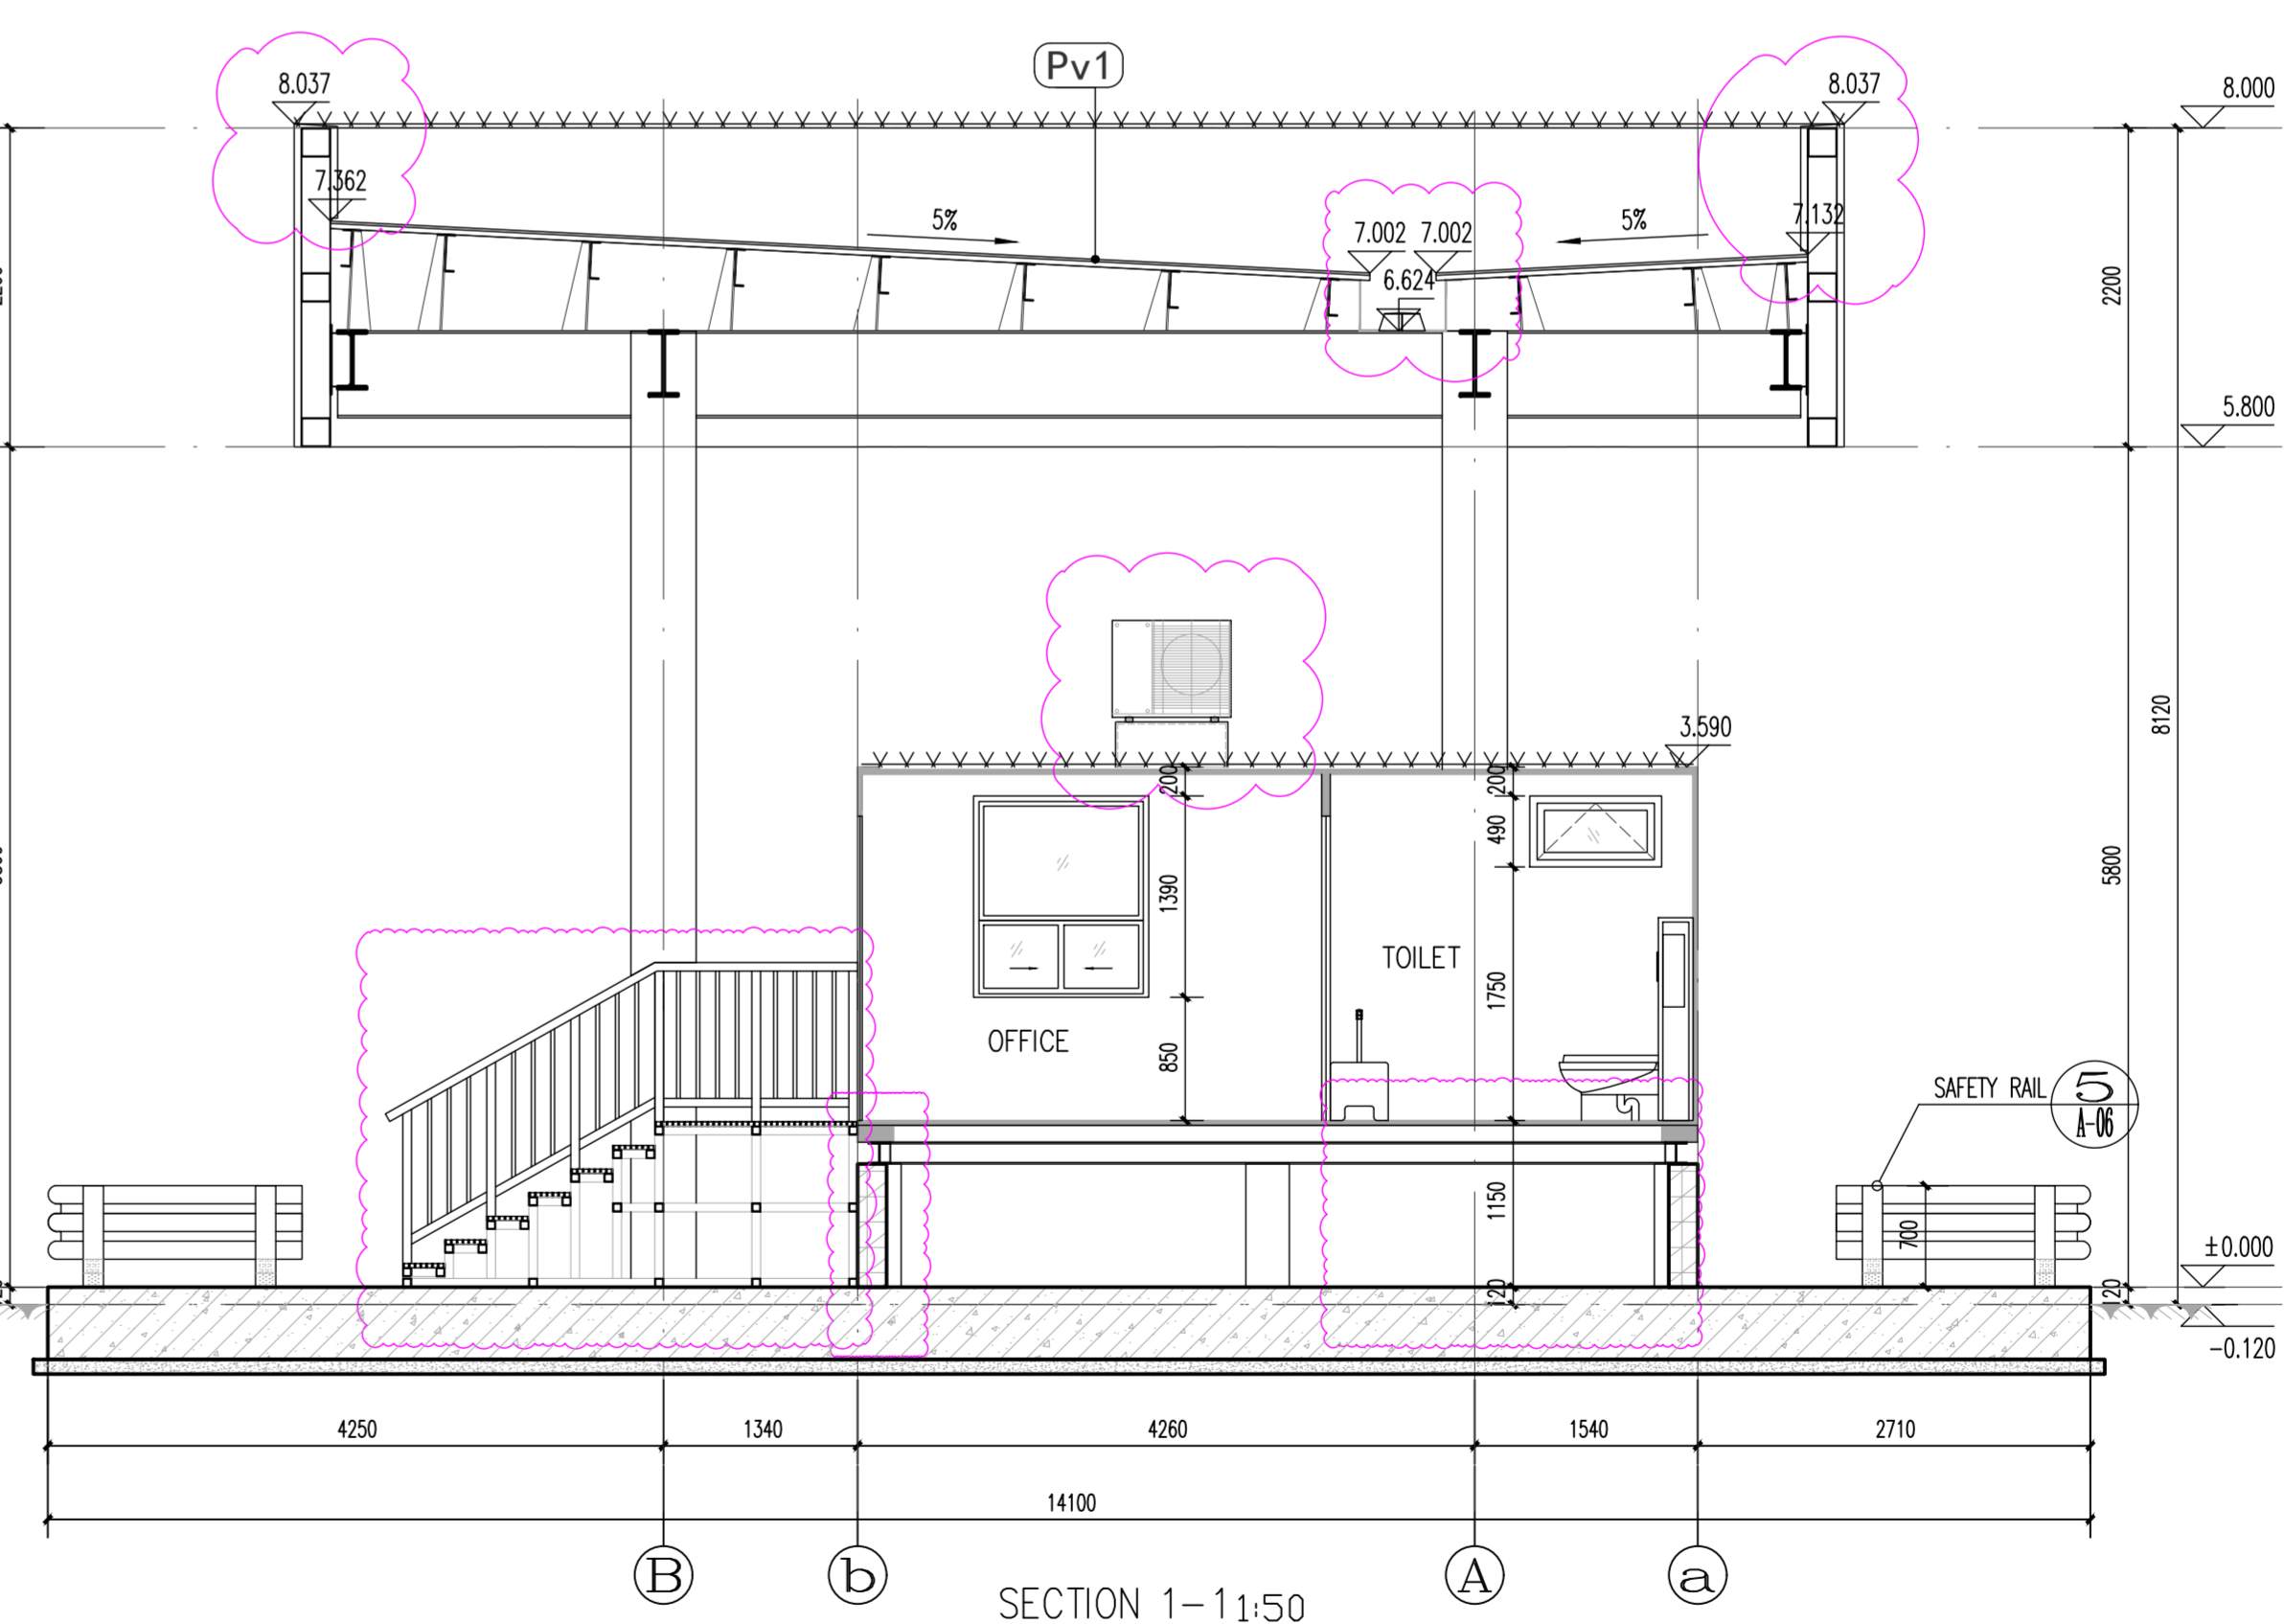

SECTION 1-1 1:50

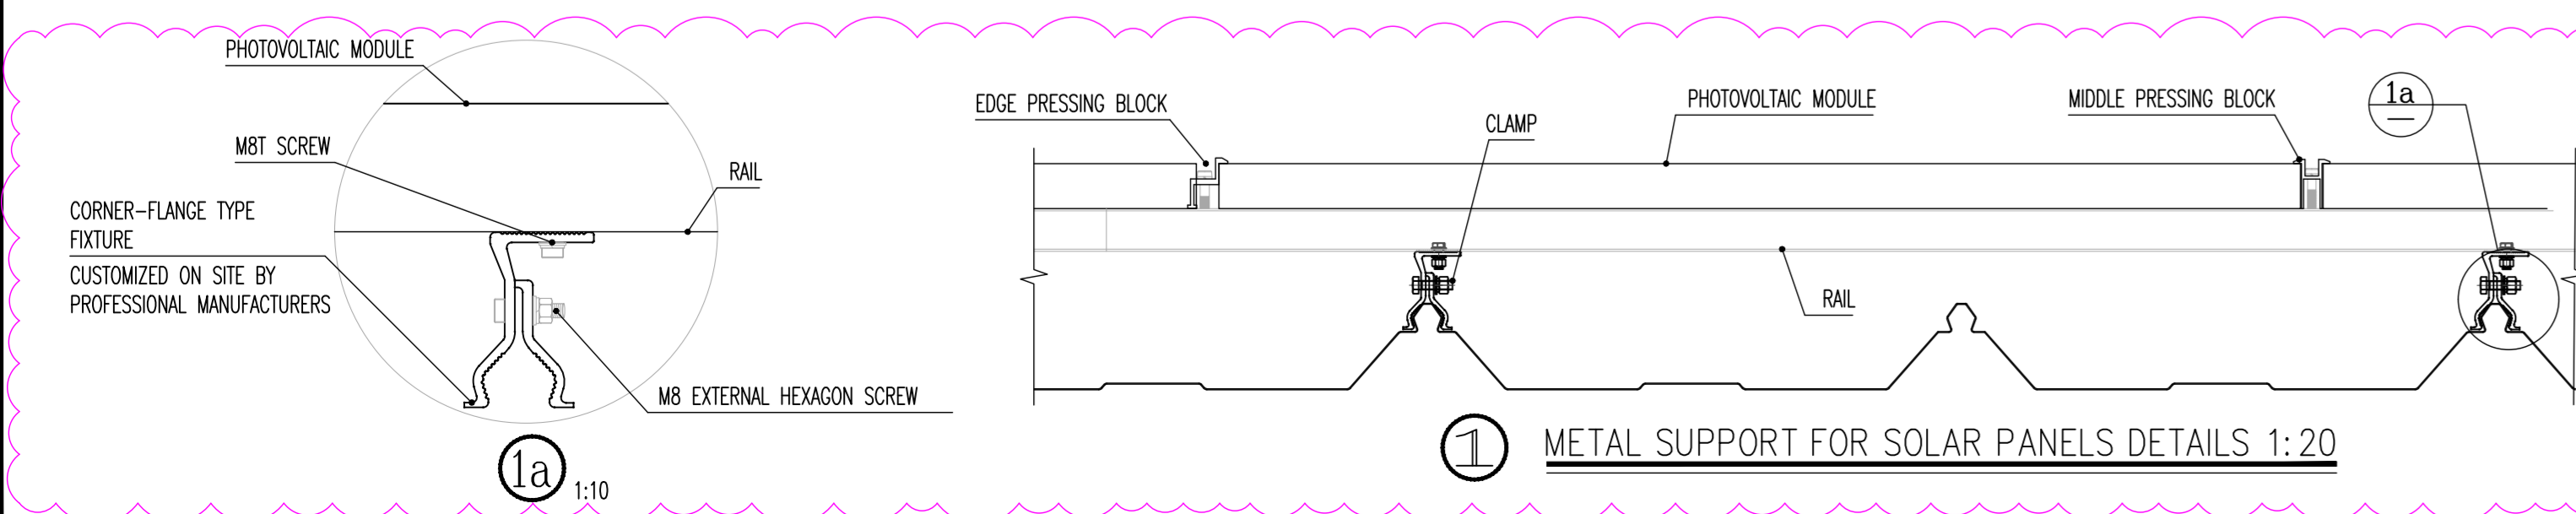

NOTES:
SOLAR PANELS SUPPORTS WILL BE PREPARED AND DETAILED BY THE SUPPLIER, AND ITS METAL COMPONENTS SHOULD MEET THE C5 CORROSION RESISTANCE REQUIREMENTS, WITH THICKNESS OF ANTI-CORROSION PAINT NDT $\geq 240\mu\text{m}$, INCLUDING $70\mu\text{m}$ OF PRIMER, $70\mu\text{m}$ OF INTERMEDIATE COATING, AND $100\mu\text{m}$ OF FINAL COATING. FASTENERS SHOULD BE EFFECTIVELY SECURED AND FIRMLY FIXED. THE WATERPROOF LEVEL AND PERFORMANCE OF SEALING COMPONENTS OF SOLAR SUPPORTS SHOULD BE CONSISTENT WITH THAT OF THE ROOF, AND THE ORIGINAL WATERPROOF SYSTEM SHOULD NOT BE DAMAGED.



NOTE:
ALL DIMENSIONS SHOWN IN THE DRAWING ARE IN MILLIMETER (MM), AND ALL LEVELS OR ELEVATIONS ARE IN METER (M) UNLESS OTHERWISE SPECIFIED.

LEGENDS	
	PROFILED STEEL SHEET (RAL 9006)
	PAINT SPRAYING (RAL 9006)
	EXTERIOR WALL OF OFFICE CONTAINER (RAL 9006)
	SIGNALING PAINT (RAL 9004 AND RAL 1003)
	STAINLESS STEEL BIRD PROTECTION

Engineer Approval Codes			
Code Nr	Condition	Signature	Date
Code 1	Noted	Employer's Representative	
Code 2	Noted with comments		
Code 3	Rejected		
Work may proceed			
Work may not proceed			
Revise and resubmit			
01	Revised according to RAD-CRBC-128 (ARCH Part)	23/03/2025	
02	First Submittals	20/12/2024	
REVISION	DESCRIPTION	DATE	CHECKED
EMPLOYER			
PORTO DE CAIO CABINDA			
Caioporto S.A.			
Avenida Comandante Gika n°150			
CP 1276 Sagrada Família			
Luanda, Angola			
EMPLOYER'S REPRESENTATIVE/ENGINEER			
Sellhorn Ingenieurgesellschaft mbH			
Trafelstr. 5, D-20459 Hamburg, Germany			
Tel: +49 (0) 36 12 01-0			
Fax: +49 (0) 36 12 01-28			
E-Mail: info@sellhorn-hamburg.de			
www.sellhorn-hamburg.de			
CONSULTANT			
Sellhorn Ingenieurgesellschaft mbH			
Trafelstr. 5, D-20459 Hamburg, Germany			
Tel: +49 (0) 36 12 01-0			
Fax: +49 (0) 36 12 01-28			
E-Mail: info@sellhorn-hamburg.de			
www.sellhorn-hamburg.de			
CONTRACTOR			
Chitra Road and Bridge Corporation			
R. Feres Mendes Pinto 55			
Alameda, Luanda, Angola			
Fax: +244 22 232 7003			
http://www.cbbc.com/			
PROJECT			
The Project of the New Port of Caio in Cabinda			
DRAWING TITLE			
Onshore Buildings_Free Zone Gate 2			
Elevations and Section			
DATE	DESIGNED BY	DRAWN BY	CHECKED BY
23/03/2025		23/03/2025	23/03/2025
NAME			
DESIGN STAGE	DETAILED DESIGN		
SCALE	1:100		
DRAWING N°	LOT1_DD_1027-A-03		