


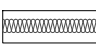



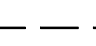

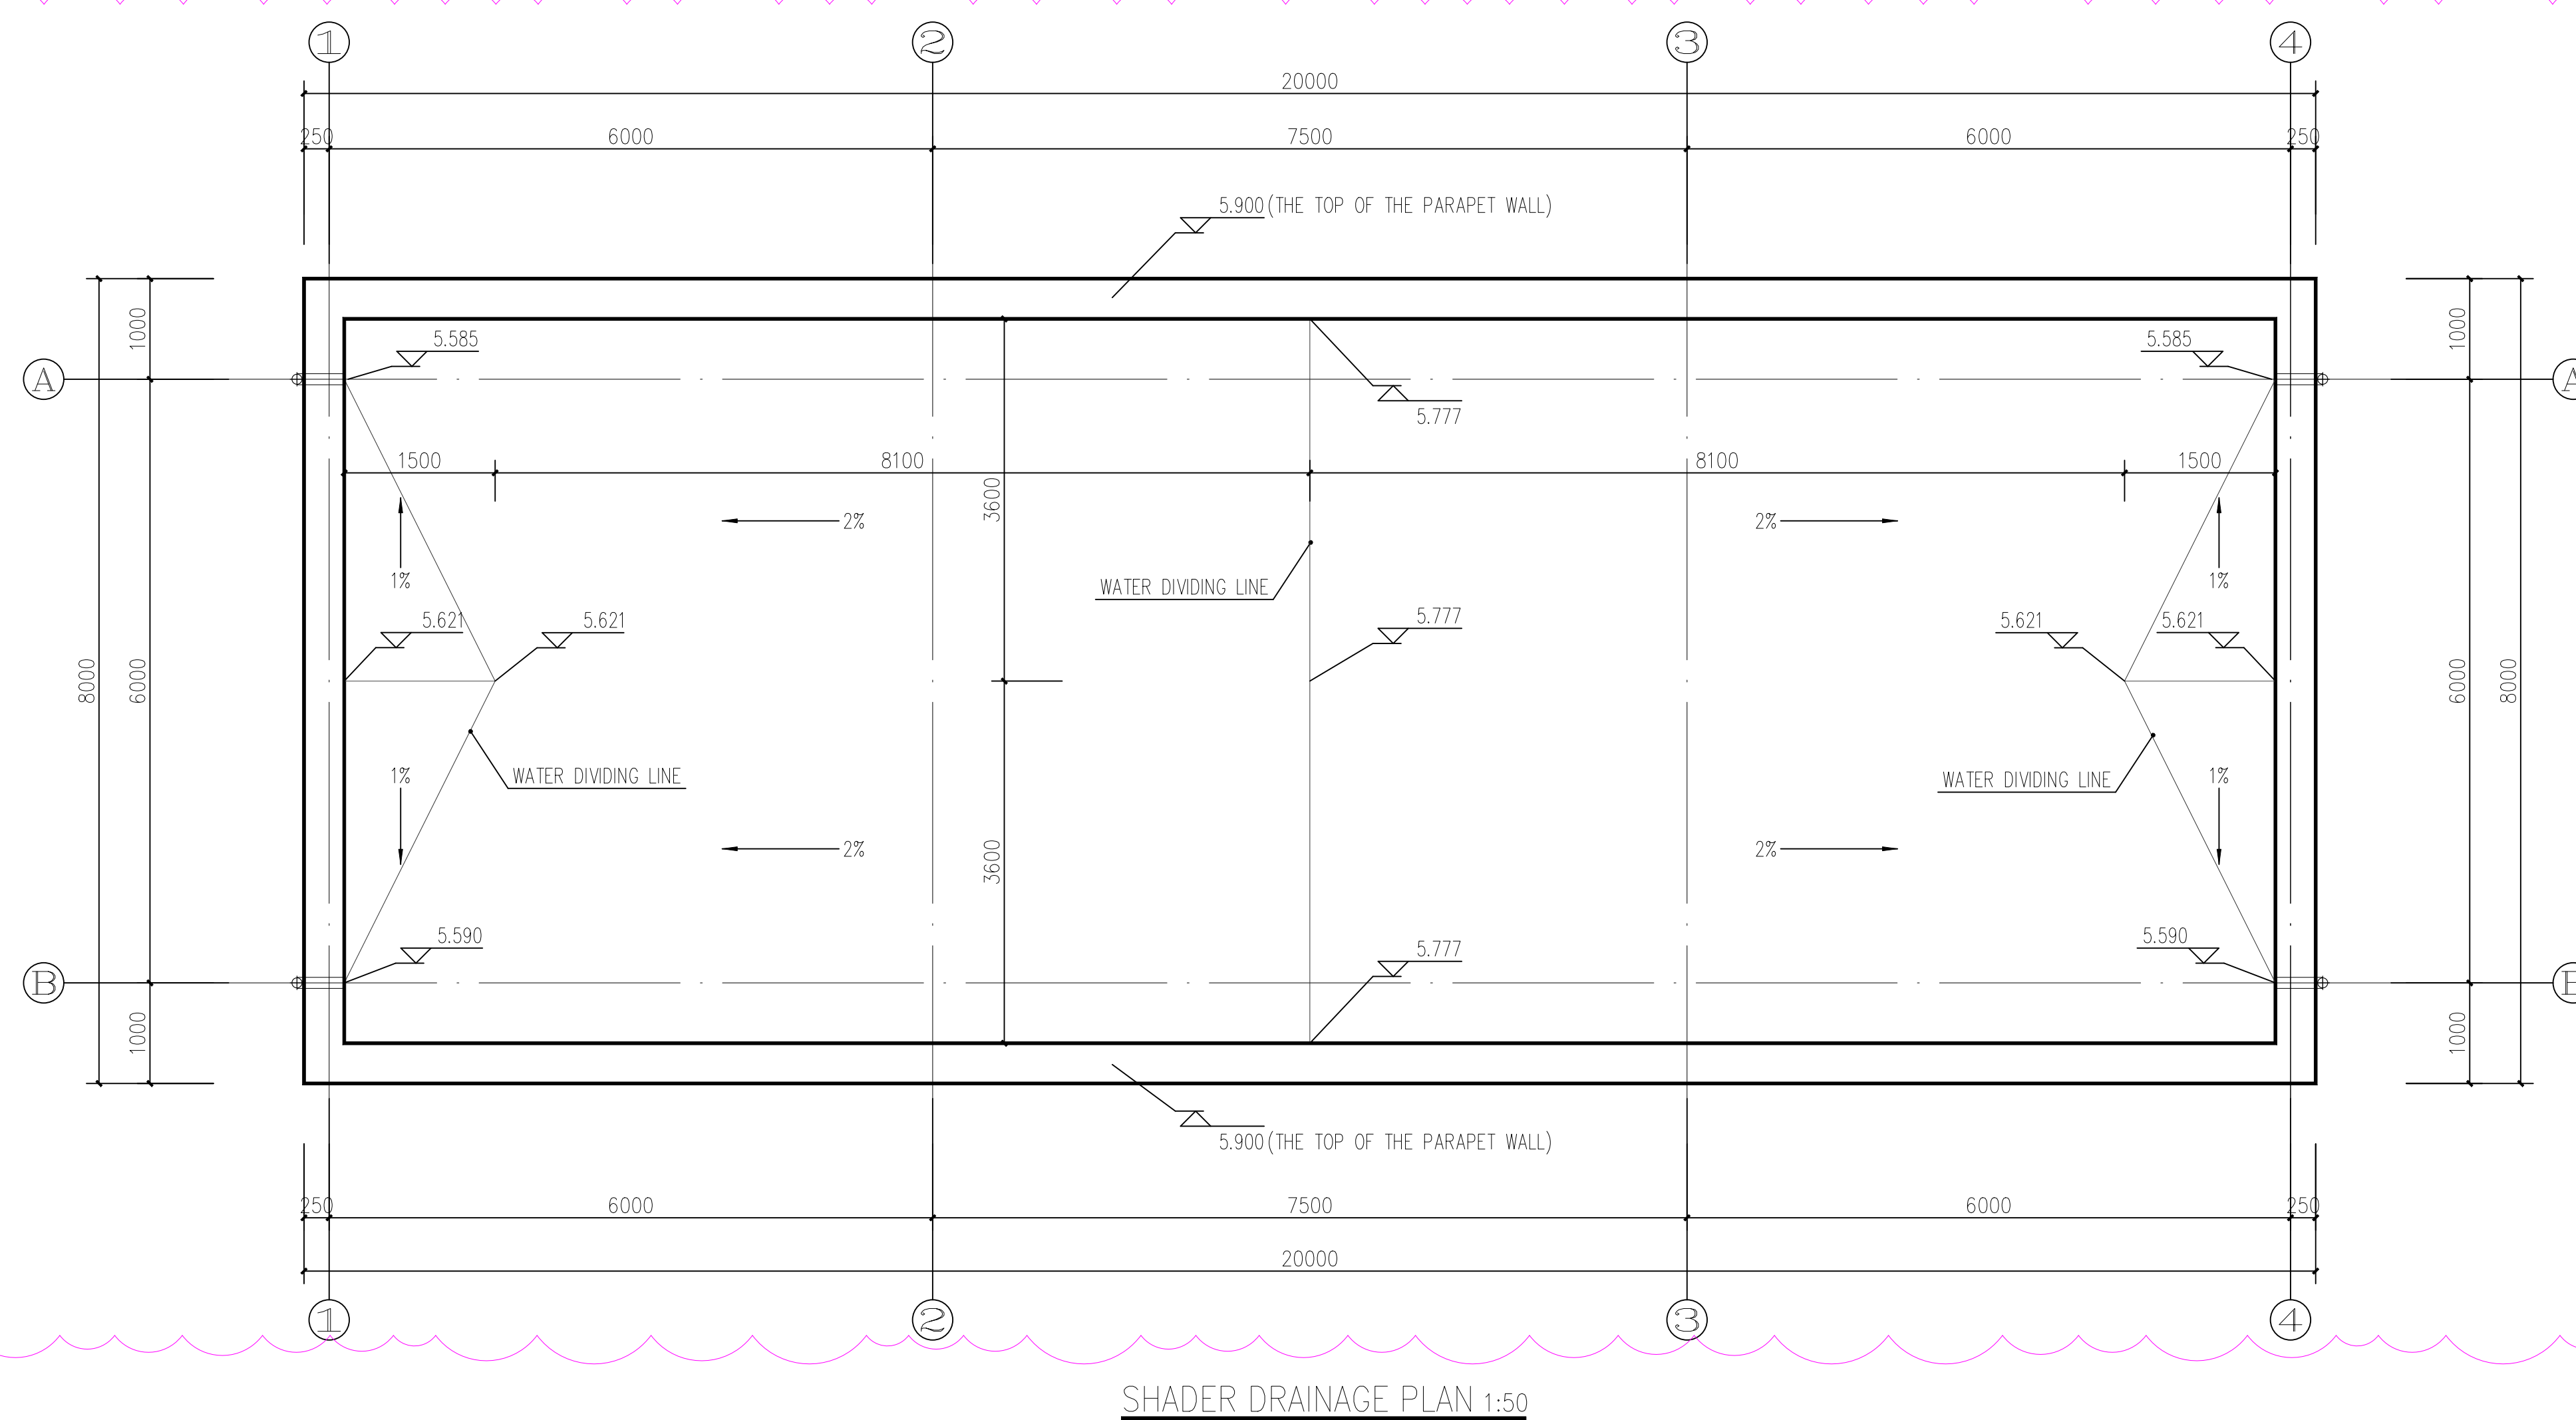








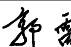

NOTE:

ALL DIMENSIONS SHOWN IN THE DRAWING ARE IN MILLIMETER (MM), AND ALL LEVELS OR ELEVATIONS ARE IN METER (M) UNLESS OTHERWISE SPECIFIED.

LEGENDS

	REINFORCED CONCRETE
	CONCRETE
	RAMMED EARTH
	ROCK WOOL BOARD
	EXTERIOR WALL OF OFFICE CONTAINER (RAL 9016)
	CONCRETE HOLLOW BRICK
	ANCHORAGE POINES
	HORIZONTAL LIFELINE
	STORMWATER STACK PIPE



		Engineer Approval Codes		
Code Nr	Condition	Signature Employer's Representative	Date	
Code 1	Noted Work may proceed.			
Code 2	Noted with comments Work may proceed.			
Code 3	Rejected Work may not proceed. Revise and resubmit.			
01	Revised according to RAD-CRBC-134(ARCH Part)	23/03/2024	L - 01	
00	First Submittals	20/12/2024	L - 01	
REVISION	DESCRIPTION	DATE	CHECKED	
EMPLOYER		 PORTO DE CAIO CABINDA Caioporto S.A. Avenida Comandante Gika n° 150 CP 1276 Sagrada Família Luanda, Angola		
EMPLOYER'S REPRESENTATIVE/ENGINEER		  Sellhorn Ingenieurgesellschaft mbH Teitfeld 5, D-20459 Hamburg, Germany Tel: +49 (40) 36 12 01-0 Fax: +49 (40) 36 12 01-28 E-Mail: info@sellhorn-hamburg.de www.sellhorn-hamburg.de		
CONSULTANT		  Sellhorn Ingenieurgesellschaft mbH Teitfeld 5, D-20459 Hamburg, Germany Tel: +49 (40) 36 12 01-0 Fax: +49 (40) 36 12 01-28 E-Mail: info@sellhorn-hamburg.de www.sellhorn-hamburg.de		
CONTRACTOR		 China Road and Bridge Corporation R. Ferno Mendes Pinto 55 Avenida, Luanda, Angola Fax: +244 22 322 7003 http://www.crbc.com/'		
PROJECT				
The Project of the New Port of Caio in Cabinda				
DRAWING TITLE				
Onshore Buildings_Personal Gate Roof Drainage Plan				
DESIGNED BY	DRAWN BY	CHECKED BY	SCALE	DRAWING N°
DATE	20/03/2025	22/03/2025	23/03/2025	
NAME			L - 01	1:50
DESIGN STAGE	DETAILED DESIGN			LOT1_DD_1021-A-04