



SHADER EQUIPMENT PLAN 1:50





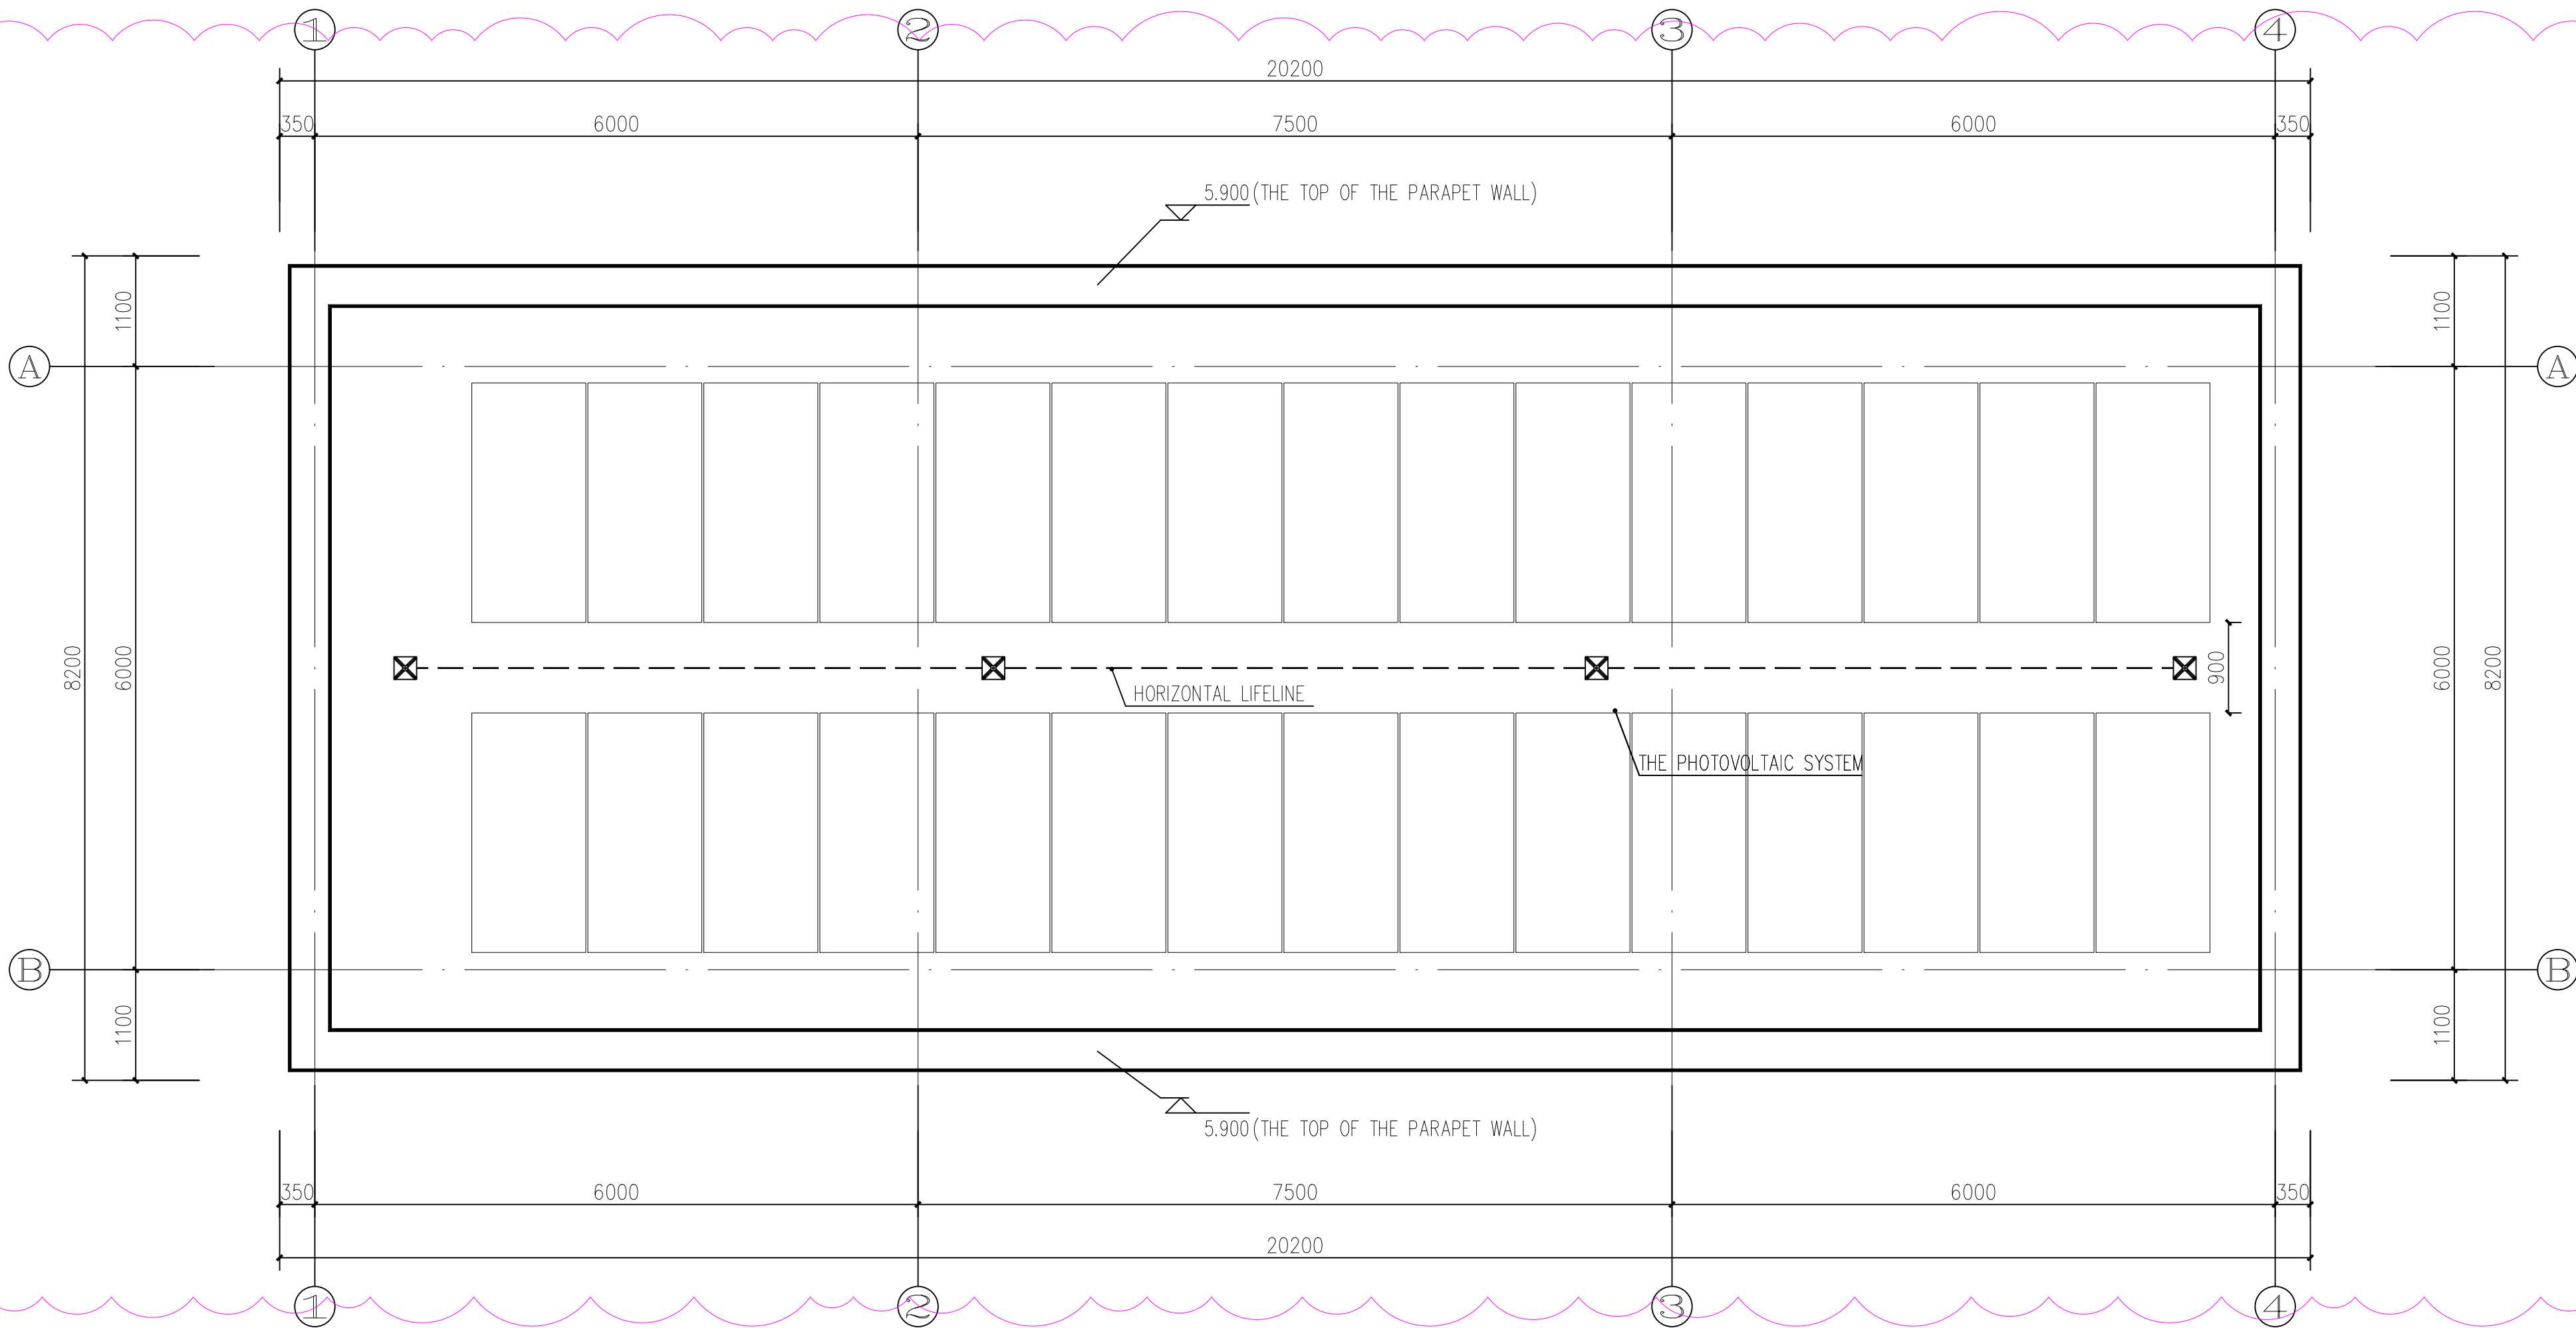

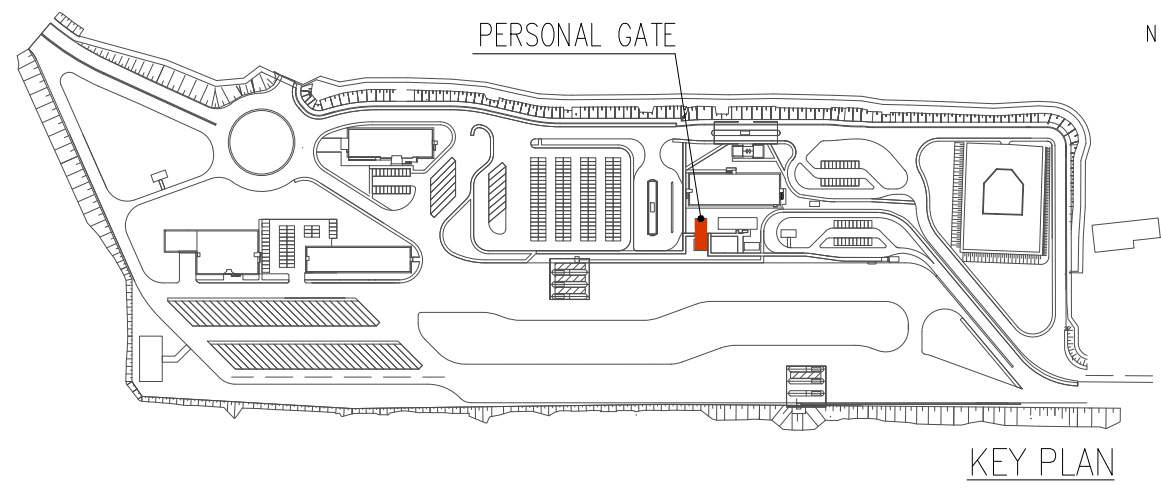

SHADER PLAN 1:50



NOTE:
ALL DIMENSIONS SHOWN IN THE DRAWING ARE IN MILLIMETER (MM), AND ALL LEVELS OR ELEVATIONS ARE IN METER (M) UNLESS OTHERWISE SPECIFIED.

LEGENDS

	REINFORCED CONCRETE
	CONCRETE
	RAMMED EARTH
	ROCK WOOL BOARD
	EXTERIOR WALL OF OFFICE CONTAINER (RAL 9016)
	CONCRETE HOLLOW BRICK
	ANCHORAGE PINES
	HORIZONTAL LIFELINE
	STORMWATER STACK PIPE

Engineer Approval Codes			
Code Nr	Condition	Signature Employer's Representative	Date
Code 1	Noted Work may proceed.		
Code 2	Noted with comments Work may proceed.		
Code 3	Rejected Work may not proceed. Revise and resubmit.		
01	Revised according to RAD-CRBC-134(ARCH Part)	23/03/2024	✓ - MR
00	First Submittals	20/12/2024	✓ - MR
REVISION	DESCRIPTION	DATE	CHECKED
EMPLOYER			
		Caioporto S.A. Avenida Comandante Gika n °150 CP 1276 Sagrada Familia Luanda, Angola	
EMPLOYER'S REPRESENTATIVE/ENGINEER		Sellhorn Ingenieurgesellschaft mbH Tiefelfeld 5, D-20459 Hamburg, Germany Tel: +49 (40) 36 12 01-0 Fax: +49 (40) 36 12 01-28 E-Mail: info@sellhorn-hamburg.de www.sellhorn-hamburg.de	
			
CONSULTANT		Sellhorn Ingenieurgesellschaft mbH Tiefelfeld 5, D-20459 Hamburg, Germany Tel: +49 (40) 36 12 01-0 Fax: +49 (40) 36 12 01-28 E-Mail: info@sellhorn-hamburg.de www.sellhorn-hamburg.de	
			
CONTRACTOR			
		China Road and Bridge Corporation R. Femenao Mendes Pinto 55 Avalade, Luanda, Angola Fax: +244 22 232 7003 http://www.crbc.com/	
PROJECT			
The Project of the New Port of Caio in Cabinda			
DRAWING TITLE			
Onshore Buildings_Personal Gate Shader Plan			
DRAWING N°			
LOT1_DD_1021-A-04-1			
SCALE			
1:50			
DESIGNED BY			
20/03/2025			
DRAWN BY			
22/03/2025			
CHECKED BY			
23/03/2025			
DATE			
20/03/2025			
NAME			
新吉			
DESIGN STAGE			
DETAILED DESIGN			