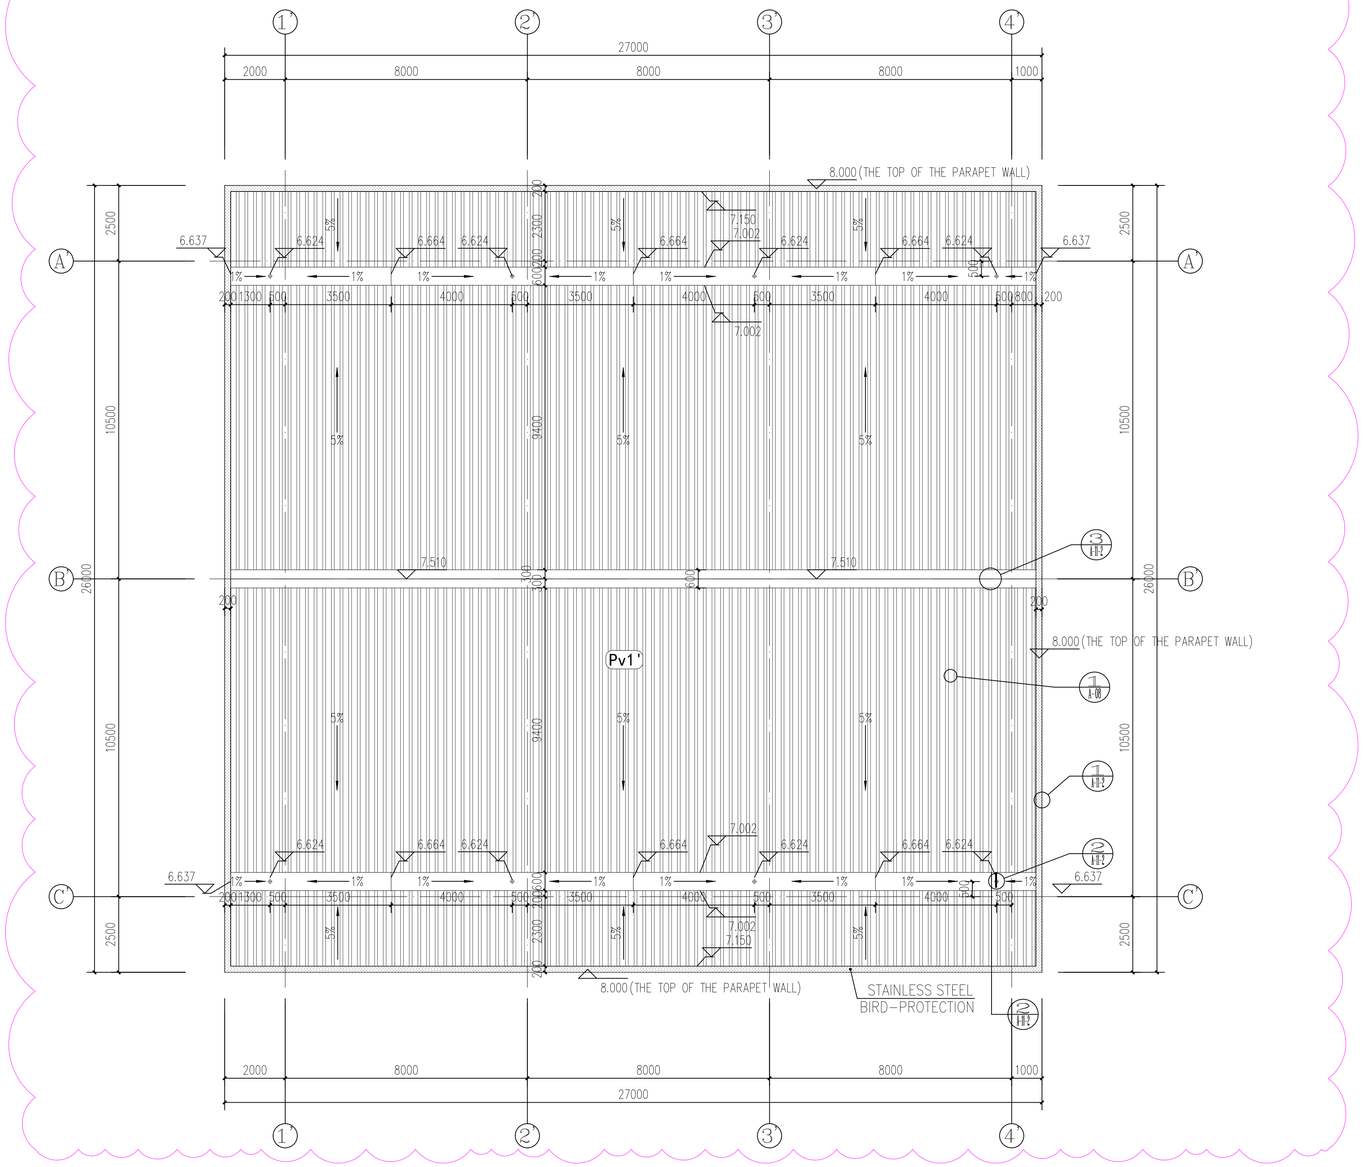

ROOF DRAINAGE OUTBOUND PLAN 1:100

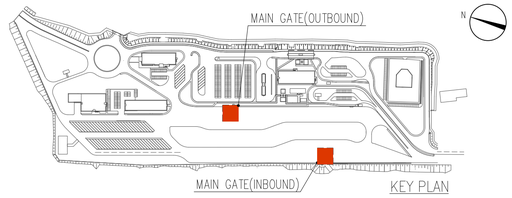

NOTE:

ALL DIMENSIONS SHOWN IN THE DRAWING ARE IN MILLIMETER (MM), AND ALL LEVELS OR ELEVATIONS ARE IN METER (M) UNLESS OTHERWISE SPECIFIED.

LEGENDS:

	PROFILED STEEL SHEET (RAL 9006)

Engineer Approval Codes

Code Nr	Condition	Signature Employer's Representative	Date
Code 1	Noted Work may proceed.		
Code 2	Noted with comments Work may proceed.		
Code 3	Rejected Work may not proceed. Revise and resubmit.		

REVISION	DESCRIPTION	DATE	CHECKED
01	Revised according to RAD-CRBC-136(ARCH Part)	22/03/2025	
00	First Submittals	20/12/2024	

EMPLOYER

PORTO DE CAIO CABINDA

Caioporto S.A.
Avenida Comandante Gika n °150
CP 1276 Sagrada Familia
Luanda, Angola

EMPLOYER'S REPRESENTATIVE/ENGINEER

Sellhorn INGENIEURGESELLSCHAFT HPC

Sellhorn Ingenieurgesellschaft mbH
Telfeld 5, D-20459 Hamburg, Germany
Tel: +49 (40) 36 12 01-0
Fax: +49 (40) 36 12 01-28
E-Mail: info@sellhorn-hamburg.de
www.sellhorn-hamburg.de

CONSULTANT

Sellhorn INGENIEURGESELLSCHAFT HPC

Sellhorn Ingenieurgesellschaft mbH
Telfeld 5, D-20459 Hamburg, Germany
Tel: +49 (40) 36 12 01-0
Fax: +49 (40) 36 12 01-28
E-Mail: info@sellhorn-hamburg.de
www.sellhorn-hamburg.de

CONTRACTOR

RB

China Road and Bridge Corporation
R. Fernao Mendes Pinto 55
Alvalade, Luanda, Angola
Fax: +244 22 232 7003
http://www.crbc.com/

PROJECT

The Project of the New Port of Caio in Cabinda

DRAWING TITLE

Onshore Buildings_Main Gate
Roof Drainage Outbound Plan

	DESIGNED BY	DRAWN BY	CHECKED BY	SCALE	DRAWING N°
DATE	20/03/2025	20/03/2025	22/03/2025	1:100	LOT1_DD_1020-A-08-1
NAME					
DESIGN STAGE	DETAILED DESIGN				

IT IS NOT ALLOWED TO REPRODUCE IT'S CONTENTS IN ANY FORMAT, EXCEPT OF THE PURPOSE WHICH IT IS ORIGINALLY INTENDED FOR.